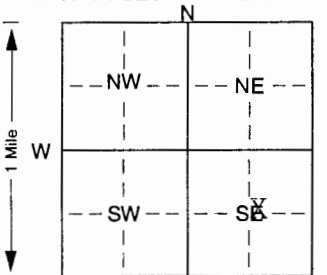


1 LOCATION OF WATER WELL: Fraction  $\frac{1}{4}$  N/C  $\frac{1}{4}$  SE  $\frac{1}{4}$  Section Number 23 Township Number T 27 S Range Number R 20 ~~EW~~

Distance and direction from nearest town or city street address of well if located within city?  
5 3/4 north of Mullinville, KS

2 WATER WELL OWNER: Russell Fralick #18,280  
RR#, St. Address, Box # : Box 66 Board of Agriculture, Division of Water Resources  
City, State, ZIP Code : Mullinville, KS 67109 Application Number:

3 LOCATE WELL'S LOCATION WITH AN "X" IN SECTION BOX:  4 DEPTH OF COMPLETED WELL: 107 ft. ELEVATION:   
Depth(s) Groundwater Encountered 1 ft. 2. ft. 3. ft.  
WELL'S STATIC WATER LEVEL 49 ft. below land surface measured on mo/day/yr 3-19-02  
Pump test data: Well water was 61 1/2 ft. after 4 hours pumping 900 gpm  
Est. Yield 1200 gpm: Well water was 64 ft. after 6 hours pumping 1200 gpm  
Bore Hole Diameter 28 in. to . ft. and . in. to . ft.  
WELL WATER TO BE USED AS: 5 Public water supply 8 Air conditioning 11 Injection well  
1 Domestic 3 Feedlot 6 Oil field water supply 9 Dewatering 12 Other (Specify below)  
2 Irrigation 4 Industrial 7 Domestic (lawn & garden) 10 Monitoring well  
Was a chemical/bacteriological sample submitted to Department? Yes. . . . . No.  ; If yes, mo/day/yr sample was submitted Water Well Disinfected? Yes No

5 TYPE OF BLANK CASING USED: 5 Wrought iron 8 Concrete tile CASING JOINTS: Glued.  Clamped. . . . .  
1 Steel 3 RMP (SR) 6 Asbestos-Cement 9 Other (specify below) Welded . . . . .  
2 PVC 4 ABS 7 Fiberglass . . . . . Threaded . . . . .  
Blank casing diameter 16 in. to 67 ft., Dia . . . . . in. to . ft., Dia . . . . . in. to . ft.  
Casing height above land surface 12 in., weight sch 40 lbs./ft. Wall thickness or gauge No. . . . .  
TYPE OF SCREEN OR PERFORATION MATERIAL: 7 PVC 10 Asbestos-cement  
1 Steel 3 Stainless steel 5 Fiberglass 8 RMP (SR) 11 Other (specify) . . . . .  
2 Brass 4 Galvanized steel 6 Concrete tile 9 ABS 12 None used (open hole)  
SCREEN OR PERFORATION OPENINGS ARE: 5 Gauzed wrapped 8 Saw cut 11 None (open hole)  
1 Continuous slot 3 Mill slot 6 Wire wrapped 9 Drilled holes  
2 Louvered shutter 4 Key punched 7 Torch cut 10 Other (specify) . . . . . ft.  
SCREEN-PERFORATED INTERVALS: From 107 ft. to 67 ft., From . . . . . ft. to . . . . . ft.  
GRAVEL PACK INTERVALS: From 107 ft. to 20 ft., From . . . . . ft. to . . . . . ft.

6 GROUT MATERIAL: 1 Neat cement 2 Cement grout 3 Bentonite 4 Other hole plug  
Grout Intervals: From 20 ft. to 0 ft., From . . . . . ft. to . . . . . ft., From . . . . . ft. to . . . . . ft.  
What is the nearest source of possible contamination:  
1 Septic tank 4 Lateral lines 7 Pit privy 10 Livestock pens 14 Abandoned water well  
2 Sewer lines 5 Cess pool 8 Sewage lagoon 11 Fuel storage 15 Oil well/Gas well  
3 Watertight sewer lines 6 Seepage pit 9 Feedyard 12 Fertilizer storage 16 Other (specify below)  
13 Insecticide storage None  
Direction from well? How many feet?

FROM	TO	LITHOLOGIC LOG	FROM	TO	PLUGGING INTERVALS
0	2	top soil			
2	10	sandy clay			
10	15	sand and gravel, clay streaks			
15	20	sand and gravel, small			
20	60	sand and gravel			
60	79	sand and gravel, big			
79	90	gray clay			
90	95	clay, sand and gravel			
95	107	gray clay			

7 CONTRACTOR'S OR LANDOWNER'S CERTIFICATION: This water well was (1) constructed, (2) reconstructed, or (3) plugged under my jurisdiction and was completed on (mo/day/year) 4-18-02 and this record is true to the best of my knowledge and belief. Kansas Water Well Contractor's Licence No. 134 This Water Well Record was completed on (mo/day/yr) 4-29-02 under the business name of Rosencrantz-Bemis by (signature) Fredia Hudson