USE TYPEWRITER OR BALL POINT PEN–PRESS FIRMLY, PRINT CLEARLY.

WATER WELL RECORD
KSA 82a-1201-1215

Kansas Department of Health and Environment-Division of Environment
(Water well Contractors)
Topeka, Kansas 66620

1. Location of well:	County	Fraction	Section number	Township number	Range number
	KIOWA	SW 1/4 1/4 1/4	24	T 27 S	R 20 W E/W

2. Distance and direction from nearest town or city: 6½ N-2½ E-2N of Mullinville
Street address of well location if in city: KANSAS.

3. Owner of well: Chester R. Zimmerman
R.R. or street: RR1
City, state, zip code: Mullinville, KANSAS

4. Locate with "X" in section below:

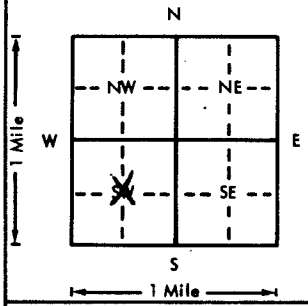

Sketch map:

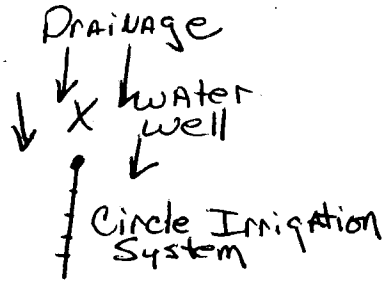

6. Bore hole dia. 24 in. Completion date —
Well depth 163 ft. 6-

7. __ Cable tool __ Rotary __ Driven __ Dug
__ Hollow rod __ Jetted __ Bored X Reverse rotary

8. Use: __ Domestic __ Public supply __ Industry
X Irrigation __ Air conditioning __ Stock
__ Lawn __ Oil field water __ Other

9. Casing: Material Steel Height: Above or below
Threaded __ Welded X Surface 20 in.
RMP __ PVC __ Weight __ lbs./ft.
Dia 24 in. to 163 ft. depth Wall Thickness: inches or
Dia. __ in. to __ ft. depth gage No. 219

5. Type and color of material	From	To
Topsoil	0	2
Sand, very fine to coarse	2	22
Small gravel	22	41
Medium to coarse gravel	41	84
Coarse gravel w/some coarse Sand	84	92
Clay, grayish brown	92	109
Clay, grayish brown/fine sand	109	120
Sand, coarse w/small gravel	120	148
Clay, grayish brown	148	163

(Use a second sheet if needed)

10. Screen Manufacturer's name W.A. Brown
Type Slot 24 Dia. 16"
Slot/gauze — Length —
Set between 43 ft. and 163 ft.
— ft. and — ft.
Gravel pack? Yes Size range of material —

11. Static water level: mo./day/yr.
24 ft. below land surface Date —

12. Pumping level below land surfaces:
54 ft. after 1 hrs. pumping 575 g.p.m.
56 ft. after 2 hrs. pumping 575 g.p.m.
Estimated maximum yield 2000 g.p.m.

13. Water sample submitted: mo./day/yr.
__ Yes X No Date —

14. Well head completion:
__ Pitless adapter — Inches above grade

15. Well grouted? Yes
With: X Neat cement __ Bentonite __ Concrete
Depth: From 10 ft. to 0 ft.

16. Nearest source of possible contamination:
ft. 1 mile Direction NW Type oil tank
Well disinfected upon completion? __ Yes X No

17. Pump: X Not installed
Manufacturer's name —
Model number — HP — Volts —
Length of drop pipe — ft. capacity — g.p.m.
Type:
__ Submersible __ Turbine
__ Jet __ Reciprocating
__ Centrifugal __ Other

18. Elevation:
Topography:
__ Hill
__ Slope
__ Upland
__ Valley

19. Remarks:

20. Water well contractor's certification:
This well was drilled under my jurisdiction and this report is true to the best of my knowledge and belief.
EWBANK, INC. 334
Business name 901 South Main License No.
Address Fairview, Okla.
Signed Rodney Ewbank Date 7-16-74
Authorized representative

T 27 R 20W Sec 24 SW 1/4 1/4 1/4

Forward the white, blue and pink copies to the Department of Health and Environment

Form WWC-5

MI-1023