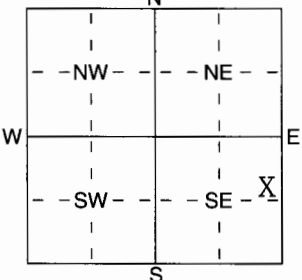


1 LOCATION OF WATER WELL: Fraction Section Number Township Number Range Number
 County: Kiowa SE 1/4 NE 1/4 SE 1/4 36 T 27 S R 20 ~~EW~~

Distance and direction from nearest town or city street address of well if located within city?
3 3/4 North, 3/4 East of Mullinville, Ks.

2 WATER WELL OWNER: Cheyenne Plains Gas Pipeline Co., LLC
 RR#, St. Address, Box # : 2 North Nevada Ave.- CWS 5th Floor Board of Agriculture, Division of Water Resources
 City, State, ZIP Code : Colorado ~~Spring~~ Springs, Co. 80903 Application Number: 46,265

3 LOCATE WELL'S LOCATION WITH AN "X" IN SECTION BOX:

 4 DEPTH OF COMPLETED WELL 148 ft. ELEVATION:
 Depth(s) Groundwater Encountered 1 ft. 2 ft. 3 ft.
 WELL'S STATIC WATER LEVEL 76 ft. below land surface measured on mo/day/yr 10-11-05
 Pump test data: Well water was 94 ft. after 2 hours pumping 850 gpm
 Est. Yield 850 gpm Well water was 97 ft. after 3 hours pumping 925 gpm
 WELL WATER TO BE USED AS: 5 Public water supply 8 Air conditioning 11 Injection well
 1 Domestic 3 Feedlot 6 Oil field water supply 9 Dewatering 12 Other (Specify below)
 2 Irrigation 4 Industrial 7 Domestic (lawn & garden) 10 Monitoring well
 Was a chemical/bacteriological sample submitted to Department? Yes No X; If yes, mo/day/yr sample was submitted
 Water Well Disinfected? Yes HTH No

5 TYPE OF BLANK CASING USED: 5 Wrought iron 8 Concrete tile CASING JOINTS: Glued X Clamped
 1 Steel 3 RMP (SR) 6 Asbestos-Cement 9 Other (specify below) Welded
 2 PVC 4 ABS 7 Fiberglass Threaded
 Blank casing diameter 16 in. to 108 ft., Dia in. to ft., Dia in. to ft.
 Casing height above land surface 18 in., weight Sch 40 lbs./ft. Wall thickness or guage No.
 TYPE OF SCREEN OR PERFORATION MATERIAL: 7 PVC 10 Asbestos-Cement
 1 Steel 3 Stainless Steel 5 Fiberglass 8 RMP (SR) 11 Other (Specify)
 2 Brass 4 Galvanized Steel 6 Concrete tile 9 ABS 12 None used (open hole)
 SCREEN OR PERFORATION OPENINGS ARE: 5 Gauzed wrapped 8 Saw cut 11 None (open hole)
 1 Continuous slot 3 Mill slot 6 Wire wrapped 9 Drilled holes
 2 Louvered shutter 4 Key punched 7 Torch cut 10 Other (specify) ft.
 SCREEN-PERFORATED INTERVALS: From 148 ft. to 108 ft., From ft. to ft.
 GRAVEL PACK INTERVALS: From 148 ft. to 20 ft., From ft. to ft.

6 GROUT MATERIAL: 1 Neat cement 2 Cement grout 3 Bentonite 4 Other
 Grout intervals: From 20 ft. to 3 ft., From ft. to ft., From ft. to ft.
 What is the nearest source of possible contamination:
 1 Septic tank 4 Lateral lines 7 Pit privy 10 Livestock pens 14 Abandoned water well
 2 Sewer lines 5 Cess pool 8 Sewage lagoon 11 Fuel storage 15 Oil well/Gas well
 3 Watertight sewer lines 6 Seepage pit 9 Feedyard 12 Fertilizer storage 16 Other (specify below)
 13 Insecticide storage None
 Direction from well? How many feet?

FROM	TO	LITHOLOGIC LOG	FROM	TO	PLUGGING INTERVALS
0	13	Fine sand			
13	20	Sandy clay			
20	35	Sand & gravel with clay mixed			
35	120	Sand & gravel			
120	121	Sand & gravel with clay mixed			
121	134	Sand & gravel			
134	136	Gravel & clay mixed			
136	140	Sand & gravel			
140	148	Gravel & clay mixed			

7 CONTRACTOR'S OR LANDOWNER'S CERTIFICATION: This water well was (1) constructed, (2) reconstructed, or (3) plugged under my jurisdiction and was completed on (mo/day/year) 1-7-06 and this record is true to the best of my knowledge and belief. Kansas Water Well Contractor's Licence No 134 This Water Well Record was completed on (mo/day/yr) 1-10-06 under the business name of Rosencrantz- Bemis by (signature) Yona Alife