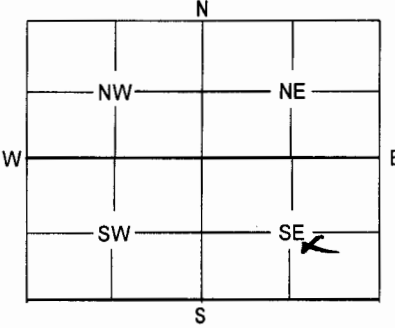


1	LOCATION OF WATER WELL:	Fraction	Section Number	Township Number	Range Number
	County: Kiowa	NW 14 SE 14 SE 14	23	27	20 E/W

Distance and direction from nearest town or city street address of well if located within city?
 6 miles north, 2 miles west of Mullinville, KS

2	WATER WELL OWNER: Brad Zimmerman	RR #, St. Address, Box # RR 1	Board of Agriculture, Division of Water Resources
	City, State, ZIP Code Mullinville, KS 67109		Application Number:

3	MARK WELL'S LOCATION WITH AN "X" IN SECTION BOX:	4	DEPTH OF WELL 82 ft.
			WELL'S STATIC WATER LEVEL 77 ft.
			WELL WAS USED AS:
			<input checked="" type="checkbox"/> Domestic <input type="checkbox"/> Irrigation <input type="checkbox"/> Feedlot <input type="checkbox"/> Industrial
			5 Public Water Supply 6 Oil Field Water Supply 7 Domestic (Lawn & Garden) 8 Air Conditioning
			9 Dewatering 10 Monitoring Well 11 Injection Well 12 Other
			Was a chemical / bacteriological sample submitted to Department? Yes No <input checked="" type="checkbox"/>
			if yes, mo/day/yr sample was submitted
			Water Well Disinfected: Yes No <input checked="" type="checkbox"/>

5	TYPE OF BLANK CASING USED:
	1 Steel 3 RMP (SR) 5 Wrought 7 Fiberglass 9 Other (Specify below) <input checked="" type="checkbox"/> PVC 4 ABS 6 Asbestos-Cement 8 Concrete Tile
	Blank casing diameter 4 in. Was casing pulled? Yes No <input checked="" type="checkbox"/> If yes, how much None
	Casing height above or below land surface 36 below in.

6	GROUT PLUG MATERIAL: 1 Neat cement 2 Cement grout <input checked="" type="checkbox"/> Bentonite 4 Other
	Grout Plug Intervals: From 82 ft. to 3 ft., From ft. to ft., From to ft.
	What is the nearest source of possible contamination:
	1 Septic tank 6 Seepage pit 11 Fuel storage 2 Sewer lines 7 Pit privy 12 Fertilizer storage 3 Watertight sewer lines 8 Sewage lagoon 13 Insecticide storage 4 Lateral lines 9 Feedyard 14 Abandoned water well 5 Cess pool 10 Livestock pens 15 Oil well/Gas well
	<input checked="" type="checkbox"/> Other (specify below) Pasture ground
	Direction from well? 999 How many feet? 999

FROM	TO	PLUGGING MATERIALS
82	3	3/8 Bentonite chips
		Clorox was placed in the water; bentonite was
		hydrated from bottom of hole to surface

7	CONTRACTOR'S OF LANDOWNER'S CERTIFICATION: This water well was plugged under my jurisdiction and was completed on (mo/day/year) 6-1-06 and this record is true to the best of my knowledge and belief. Kansas
	Water Well Contractor's License No. 665 This Water Well Record was completed on (mo/day/year) 7-19-06
	by (signature) <i>John E. Gell</i> Under the business name of Pratt Well Environmental

INSTRUCTIONS: Use typewriter or ball point pen. Please press firmly and print clearly. Please fill in blanks, underline or circle the correct answers. Send top three copies to Kansas Department of Health and Environment, Bureau of Water, Geology Section, 1 000 SW Jackson St., Ste. 420, Topeka, Kansas 66612-1367. Telephone: 785/296-5522. Send one to Water Well Owner and retain one for your records.