

WATER WELL RECORD

Form WWC-5

Division of Water Resources App. No.


20130947

1 LOCATION OF WATER WELL: County: Kiowa	Fraction ¼ NW ¼ NE ¼ NW ¼	Section Number 1	Township No. T 27 S	Range Number R 20 <input type="checkbox"/> E <input checked="" type="checkbox"/> W
---	------------------------------	---------------------	------------------------	---

Street/Rural Address of Well Location; if unknown, distance & direction from nearest town or intersection: If at owner's address, check here .
6N, 1/2E, 3N of Mullinville, KS

Global Positioning System (GPS) information:
 Latitude: (in decimal degrees)
 Longitude: (in decimal degrees)
 Elevation:
 Datum: WGS 84, NAD 83, NAD 27
 Collection Method:
 GPS unit (Make/Model:)
 Digital Map/Photo, Topographic Map, Land Survey
 Est. Accuracy: <3 m, 3-5 m, 5-15 m, >15 m

2 WATER WELL OWNER: Brack Revocable Trust
 RR#, Street Address, Box #: 2495 70th Ave.
 City, State, ZIP Code : Mullinville, KS 67109

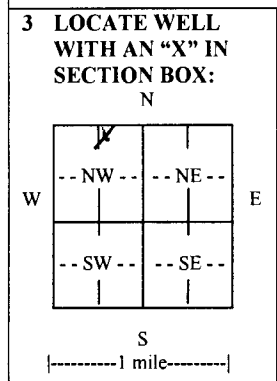

4 DEPTH OF COMPLETED WELL 100 ft.
 Depth(s) Groundwater Encountered (1). 60 ft. (2)..... ft. (3)..... ft.
 WELL'S STATIC WATER LEVEL 60 ft. below land surface measured on mo/day/yr. 12/04/13.....
 Pump test data: Well water wasft. after hours pumping gpm
 EST. YIELD. 60gpm. Well water wasft. after hours pumping gpm
 Bore Hole Diameterin. toft., andin. toft.
 WELL WATER TO BE USED AS: Public water supply Geothermal Injection well
 Domestic Feedlot Oil field water supply Dewatering Other (Specify below)
 Irrigation Industrial Domestic-lawn & garden Monitoring well
 Was a chemical/bacteriological sample submitted to Department? Yes No
 If yes, mo/day/yr sample was submitted.....
 Water well disinfected? Yes No

5 TYPE OF CASING USED: Steel PVC Other
 CASING JOINTS: Glued Clamped Welded Threaded
 Casing diameter .5 in. to .80 ft., Diameter in. to ft., Diameter in. to ft.
 Casing height above land surface .12 in., Weight 2.8 lbs./ft., Wall thickness or gauge No. Sch. 40
 TYPE OF SCREEN OR PERFORATION MATERIAL:
 Steel Stainless Steel PVC Other (Specify)
 Brass Galvanized Steel None used (open hole)
 SCREEN OR PERFORATION OPENINGS ARE:
 Continuous slot Mill slot Gauze wrapped Torch cut Drilled holes None (open hole)
 Louvered shutter Key punched Wire wrapped Saw cut Other (specify)
 SCREEN-PERFORATED INTERVALS: From .80 ft. to .100 ft., From ft. to ft.
 From ft. to ft., From ft. to ft.
 GRAVEL PACK INTERVALS: From .23 ft. to .100 ft., From ft. to ft.
 From ft. to ft., From ft. to ft.

6 GROUT MATERIAL: Neat cement Cement grout Bentonite Other
 Grout Intervals: From .0 ft. to .23 ft., From ft. to ft., From ft. to ft.
 What is the nearest source of possible contamination:
 Septic tank Lateral lines Pit privy Livestock pens Insecticide storage Other (specify below)
 Sewer lines Cesspool Sewage lagoon Fuel storage Abandoned water well
 Watertight sewer lines Seepage pit Feedyard Fertilizer storage Oil well/gas well
 Direction from well South Southwest Distance from well .115

FROM	TO	LITHOLOGIC LOG	FROM	TO	LITHO. LOG (cont.) or PLUGGING INTERVALS
0	10	top soil			
10	19	sandy clay			Miller Trust B1-1
19	100	sand and gravel clay bottom			
					Sterling Drilling Company
					P O Box 1006
					Pratt, KS 67124

7 CONTRACTOR'S OR LANDOWNER'S CERTIFICATION: This water well was constructed, reconstructed, or plugged under my jurisdiction and was completed on (mo/day/year) 12/4/13 and this record is true to the best of my knowledge and belief.
 Kansas Water Well Contractor's License No. 186 This Water Well Record was completed on (mo/day/year) 12/10/13
 under the business name of Kelly's Water Well Service, Inc. by (signature) *Kathryn L. Lhad*

INSTRUCTIONS: Use typewriter or ball point pen. PLEASE PRESS FIRMLY and PRINT clearly. Please fill in blanks and check the correct answers. Send one copy to Kansas Department of Health and Environment, Bureau of Water, Geology Section, 1000 SW Jackson St., Suite 420, Topeka, Kansas 66612-1367. Telephone 785-296-5524. Send one copy to WATER WELL OWNER and retain one for your records. Include fee of \$5.00 for each constructed well. Visit us at <http://www.kdheks.gov/waterwell/index.html>



ASSIGNMENT OF WATER WELL TO LANDOWNER

I, **Bruce & Priscilla Brack** of **2495 70th Avenue**
(Landowner's address)

Mullinville KS 67109 am the landowner on which a water well is located in
(City) (State)
the **NW** quarter of the **NE** quarter of the **NW** quarter in Section **1**, Township **27s**,
Range **20** **E/W**, in **Kiowa** County, Kansas which is approximately
5070 feet north/south, and **3460** feet east/west of the apparent **SE** section
corner. The water well was drilled in **December 2013** (month/year).

I hereby request that **Strata Exploration/Sterling Drilling** leave the water well,
(Operator name)

which was drilled by Temporary Water Permit # **20130947**, unplugged, and I will
assume all responsibility for the plugging of said water well in accordance with the requirements
of the Kansas Department of Health and Environment regulation K.A.R. 28-30-7.

LANDOWNER: **Brack Rev Trust** ^{PRB 1-6-2014}
[Signature] ^{Dated Dec 19, 2012}
(Signature) *Trust* (Date)

OPERATOR:
[Signature] ^{01/02/13}
(Signature) (Date)

Bruce Brack
(Print)

By: **Gary M Talbott/Sterling Drilling**
(Agent)

IF ADDITIONAL LANDOWNER

[Signature] ^{Trustee 1-6-2014}
(Signature) (Date)

Priscilla Brack
(Print)

RECEIVED
JAN 08 2014
BUREAU OF WATER