

WATER WELL RECORD

Form WWC-5

Division of Water Resources App. No.


2598

1 LOCATION OF WATER WELL: County: Kiowa Fraction 1/4 SW 1/4 NE 1/4 SE 1/4 Section Number 24 Township No. T 27 S Range Number R 20 E W

Street/Rural Address of Well Location; if unknown, distance & direction from nearest town or intersection: If at owner's address, check here 5 1/4 North, 3/4 East of Mullinville

2 WATER WELL OWNER: Marlin Zimmerman RR#, Street Address, Box #: 9825 W 50th Terrace City, State, ZIP Code : Merriam, KS 66203

Global Positioning System (GPS) information: Latitude: Longitude: Elevation: Datum: Collection Method: Est. Accuracy:

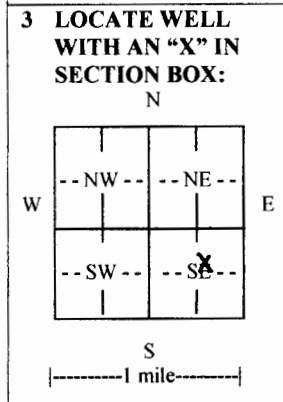

3 LOCATE WELL WITH AN 'X' IN SECTION BOX: 4 DEPTH OF COMPLETED WELL 145 ft. Depth(s) Groundwater Encountered (1) 70 ft. (2) ft. (3) ft. WELL'S STATIC WATER LEVEL 70 ft. below land surface measured on mo/day/yr. 2-25-16 Pump test data: Well water was 86 ft. after 3 hours pumping 1227 gpm EST. YIELD 1333 gpm Well water was 88 ft. after 3 1/2 hours pumping 1333 gpm Bore Hole Diameter 30 in. to 145 ft., and in. to ft. WELL WATER TO BE USED AS: Irrigation checked, Industrial, Domestic-lawn & garden, Monitoring well. Was a chemical/bacteriological sample submitted to Department? No checked. Water well disinfected? Yes checked.

5 TYPE OF CASING USED: PVC checked. CASING JOINTS: Glued checked. Casing diameter .16 in. to 145 ft., Diameter in. to ft., Diameter in. to ft. Casing height above land surface 18 in., Weight Sch 40 lbs./ft., Wall thickness or gauge No. TYPE OF SCREEN OR PERFORATION MATERIAL: Stainless Steel checked, PVC checked. SCREEN OR PERFORATION OPENINGS ARE: Saw cut checked. SCREEN-PERFORATED INTERVALS: From 145 ft. to 85 ft., From ft. to ft., From ft. to ft. GRAVEL PACK INTERVALS: From 145 ft. to 20 ft., From ft. to ft., From ft. to ft.

6 GROUT MATERIAL: Bentonite checked. Grout Intervals: From ft. to ft., From 20 ft. to 0 ft., From ft. to ft. What is the nearest source of possible contamination: Other (specify below) checked. Direction from well Distance from well

Table with 6 columns: FROM, TO, LITHOLOGIC LOG, FROM, TO, LITHO. LOG (cont.) or PLUGGING INTERVALS. Rows describe soil layers from 0 to 110 feet depth.

7 CONTRACTOR'S OR LANDOWNER'S CERTIFICATION: This water well was constructed checked, reconstructed, or plugged under my jurisdiction and was completed on (mo/day/year) 4-1-16 and this record is true to the best of my knowledge and belief. Kansas Water Well Contractor's License No. 134 This Water Well Record was completed on (mo/day/year) 4-25-16 under the business name of Rosencrantz-Bemis Ent Inc by (signature) Lara A. A. A.

INSTRUCTIONS: Use typewriter or ball point pen. PLEASE PRESS FIRMLY and PRINT clearly. Please fill in blanks and check the correct answers. Send one copy to Kansas Department of Health and Environment, Bureau of Water, Geology Section, 1000 SW Jackson St., Suite 420, Topeka, Kansas 66612-1367. Telephone 785-296-5524. Send one copy to WATER WELL OWNER and retain one for your records. Include fee of \$5.00 for each constructed well. Visit us at http://www.kdheks.gov/waterwell/index.html