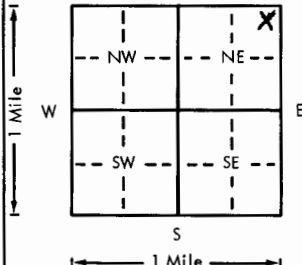


USE TYPEWRITER OR BALL
POINT PEN-PRESS FIRMLY,
PRINT CLEARLY.

WATER WELL RECORD
KSA 82a-1201-1215

Kansas Department of Health and
Environment-Division of Environment
(Water well Contractors)
Topeka, Kansas 66620

1. Location of well:		County Ford	Fraction NE 1/4 NE 1/4 NE 1/4	Section number #7	Township number T #27	Range number S R #21 E/W		
2. Distance and direction from nearest town or city: 1 1/2 miles south & 1 mile west of Windhorst, Kansas			3. Owner of well: Grant Powers Jr. R.R. or street: City, state, zip code: Spearville, Kansas 67876					
4. Locate with "X" in section below: <div style="display: flex; align-items: center;"><div style="text-align: center;"><p>Sketch map:</p></div><div style="margin-left: 20px;"><p>SEWER</p><p>NEW WELL</p><p>HOUSE</p><p>OLD WELL</p></div></div>			6. Bore hole dia. 8 in. Completion date Well depth 253 ft. 3-30-78					
5. Type and color of material			From	To	7. <input checked="" type="checkbox"/> Cable tool <input checked="" type="checkbox"/> Rotary <input type="checkbox"/> Driven <input type="checkbox"/> Dug <input type="checkbox"/> Hollow rod <input type="checkbox"/> Jetted <input type="checkbox"/> Bored <input type="checkbox"/> Reverse rotary			
			8. Use: <input checked="" type="checkbox"/> Domestic <input type="checkbox"/> Public supply <input type="checkbox"/> Industry <input type="checkbox"/> Irrigation <input type="checkbox"/> Air conditioning <input type="checkbox"/> Stock <input type="checkbox"/> Lawn <input type="checkbox"/> Oil field water <input type="checkbox"/> Other					
			9. Casing: Material RMP Height: Above or below Threading Welded Surface 12 in. RMP XX PVC Weight 12 lbs./ft. Dia. 5 in. to 253 ft. depth Wall Thickness: inches or Dia. 5 in. to 253 ft. depth gage No. 250					
			10. Screen: Manufacturer's name Sanflower Type RMP Dia. 5" Slot 1/8" Length 20 ft. Set between 208 ft. and 248 ft. ft. and 1 ft. Gravel pack? yes Size range of material 1/4"					
			11. Static water level: 60 ft. below land surface Date 3-30-78 12. Pumping level below land surfaces: 74 ft. after 1 hrs. pumping 20 g.p.m. ft. after 35 hrs. pumping 35 g.p.m. Estimated maximum yield 35 g.p.m.					
(Use a second sheet if needed)			13. Water sample submitted: Yes <input checked="" type="checkbox"/> No <input type="checkbox"/> Date		14. Well head completion: <input checked="" type="checkbox"/> Pitless adapter 12 Inches above grade			
			15. Well grouted? yes With: XX Neat cement <input type="checkbox"/> Bentonite <input type="checkbox"/> Concrete Depth: From 6 ft. to 17 ft.		16. Nearest source of possible contamination: ft. 75 Direction SW Type Sewer Well disinfected upon completion? XX Yes <input type="checkbox"/> No <input type="checkbox"/>			
			17. Pump: Not installed Manufacturer's name Goulds Model number 7EH HP 3/4 Volts 230 Length of drop pipe 188 ft. capacity 7 g.p.m. Type: <input checked="" type="checkbox"/> Submersible <input type="checkbox"/> Turbine <input type="checkbox"/> Jet <input type="checkbox"/> Reciprocating <input type="checkbox"/> Centrifugal <input type="checkbox"/> Other		20. Water well contractor's certification: This well was drilled under my jurisdiction and this report is true to the best of my knowledge and belief. Joe's Well Service 179 Business name License No. Address Box 171 Cimarron, Ks. Signed Paul C. Crick Date 5-2-78 Authorized representative			
			18. Elevation:		19. Remarks: With good drainage to the Northwest		20. Water well contractor's certification:	
			Topography: <input type="checkbox"/> Hill <input type="checkbox"/> Slope <input checked="" type="checkbox"/> Upland <input type="checkbox"/> Valley					