


1 LOCATION OF WATER WELL: County: FORD Fraction: NW 1/4 NW 1/4 SW 1/4 Section Number: 14 Township Number: T 27 S Range Number: R 21 E/W

Distance and direction from nearest town or city street address of well if located within city?

9N 2E Bucklin Kansas

2 WATER WELL OWNER: Dick Stone Board of Agriculture, Division of Water Resources  
RR#, St. Address, Box #: Bucklin Kans Application Number:  
City, State, ZIP Code:

3 LOCATE WELL'S LOCATION WITH AN "X" IN SECTION BOX: 4 DEPTH OF COMPLETED WELL: 32 ft. ELEVATION: 16 ft. 3

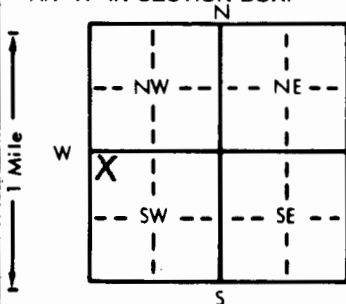

Depth(s) Groundwater Encountered 1 ft. 2 16 ft. 3 16 ft.

WELL'S STATIC WATER LEVEL 16 ft. below land surface measured on mo/day/yr 10-20-76

Pump test data: Well water was 28 ft. after 1 hours pumping 7 gpm

Est. Yield 4 gpm: Well water was 28 ft. after 1 hours pumping 7 gpm

Bore Hole Diameter 8 3/4 in. to 32 ft., and 32 in. to 32 ft.

WELL WATER TO BE USED AS: 5 Public water supply 8 Air conditioning 11 Injection well

Domestic 3 Feedlot 6 Oil field water supply 9 Dewatering 12 Other (Specify below)

2 Irrigation 4 Industrial 7 Lawn and garden only 10 Observation well

Was a chemical/bacteriological sample submitted to Department? Yes No; If yes, mo/day/yr sample was submitted

Water Well Disinfected? Yes X No

5 TYPE OF BLANK CASING USED: 1 Steel 2 PVC 3 RMP (SR) 4 ABS 5 Wrought iron 6 Asbestos-Cement 7 Fiberglass 8 Concrete tile 9 Other (specify below) CASING JOINTS: Glued X Clamped X Welded Threaded

Blank casing diameter 5 in. to 2 ft., Dia 2 in. to 2 ft., Dia 2 in. to 2 ft.

Casing height above land surface 12 in., weight 150 lbs./ft. Wall thickness or gauge No. 200

TYPE OF SCREEN OR PERFORATION MATERIAL: 1 Steel 2 Brass 3 Stainless steel 4 Galvanized steel 5 Fiberglass 6 Concrete tile 7 PVC 8 RMP (SR) 9 ABS 10 Asbestos-cement 11 Other (specify) 12 None used (open hole)

SCREEN OR PERFORATION OPENINGS ARE: 1 Continuous slot 2 Louvered shutter 3 Mill slot 4 Key punched 5 Gauzed wrapped 6 Wire wrapped 7 Torch cut 8 Saw cut 9 Drilled holes 10 Other (specify) 11 None (open hole)

SCREEN-PERFORATED INTERVALS: From 12 ft. to 32 ft., From 12 ft. to 32 ft., From 12 ft. to 32 ft.

GRAVEL PACK INTERVALS: From 14 ft. to 32 ft., From 14 ft. to 32 ft., From 14 ft. to 32 ft.

6 GROUT MATERIAL: 1 Neat cement 2 Cement grout 3 Bentonite 4 Other Grout Intervals: From 0 ft. to 10 ft., From 0 ft. to 10 ft., From 0 ft. to 10 ft.

What is the nearest source of possible contamination: 1 Septic tank 2 Sewer lines 3 Watertight sewer lines 4 Lateral lines 5 Cess pool 6 Seepage pit 7 Pit privy 8 Sewage lagoon 9 Feedyard 10 Livestock pens 11 Fuel storage 12 Fertilizer storage 13 Insecticide storage 14 Abandoned water well 15 Oil well/Gas well 16 Other (specify below)

Direction from well? SE How many feet? 50

FROM TO LITHOLOGIC LOG FROM TO LITHOLOGIC LOG

0 4 TOP SOIL

4 9 BRICKLAY

9 32 GRAVEL

7 CONTRACTOR'S OR LANDOWNER'S CERTIFICATION: This water well was (1) constructed, (2) reconstructed, or (3) plugged under my jurisdiction and was completed on (mo/day/year) 10-20-76 and this record is true to the best of my knowledge and belief. Kansas

Water Well Contractor's License No. 324 This Water Well Record was completed on (mo/day/yr) 11-2-81

under the business name of Carl Hays Water Well Serv by (signature) Carl Hays

INSTRUCTIONS: Use typewriter or ball point pen, PLEASE PRESS FIRMLY and PRINT clearly. Please fill in blanks, underline or circle the correct answers. Send top three copies to Kansas Department of Health and Environment, Division of Environment, Environmental Geology Section, Topeka, KS 66620. Send one to WATER WELL OWNER and retain one for your records.