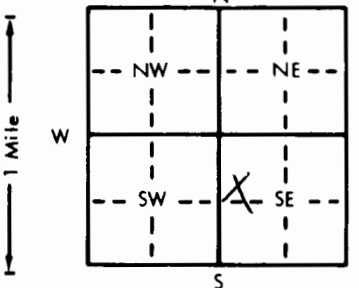


1 LOCATION OF WATER WELL:		Fraction		Section Number		Township Number		Range Number	
County: <b>Ford</b>		SW ¼ NW ¼ SE ¼		<b>19</b>		T <b>27</b> S		R <b>21</b> E/W	
Distance and direction from nearest town or city street address of well if located within city? <b>From Ford, Kansas - 1 mile North, 5½ miles East and 2 miles North, ½ mile West and ½ mile South</b>									
2 WATER WELL OWNER: <b>Slawson Drilling Co. (Heyer D #1)</b>									
RR#, St. Address, Box #: <b>P. O. Box 1409</b> Board of Agriculture, Division of Water Resources									
City, State, ZIP Code: <b>Great Bend, Kansas 67530</b> Application Number:									
3 LOCATE WELL'S LOCATION WITH AN "X" IN SECTION BOX:			4 DEPTH OF COMPLETED WELL <b>180</b> ft. ELEVATION:						
			Depth(s) Groundwater Encountered 1. .... ft. 2. .... ft. 3. .... ft.						
			WELL'S STATIC WATER LEVEL <b>43</b> ft. below land surface measured on mo/day/yr <b>3-6-83</b>						
			Pump test data: Well water was .... ft. after .... hours pumping .... gpm						
			Est. Yield <b>70</b> gpm: Well water was .... ft. after .... hours pumping .... gpm						
			Bore Hole Diameter <b>8</b> in. to <b>180</b> ft. and .... in. to .... ft.						
WELL WATER TO BE USED AS:									
1 Domestic 3 Feedlot <u>6 Oil field water supply</u> 9 Dewatering 11 Injection well									
2 Irrigation 4 Industrial 7 Lawn and garden only 10 Observation well									
Was a chemical/bacteriological sample submitted to Department? Yes ..... No <del>XXX</del> ; If yes, mo/day/yr sample was submitted									
Water Well Disinfected? Yes <del>XXX</del> No									
5 TYPE OF BLANK CASING USED:									
1 Steel 3 RMP (SR) 5 Wrought iron 8 Concrete tile CASING JOINTS: Glued <del>XXX</del> Clamped									
2 PVC 4 ABS 6 Asbestos-Cement 9 Other (specify below) Welded									
7 Fiberglass Threaded									
Blank casing diameter <b>5</b> in. to <b>180</b> ft. Dia .... in. to .... ft. Dia .... in. to .... ft.									
Casing height above land surface <b>12</b> in. weight <b>200 psi</b> lbs./ft. Wall thickness or gauge No. <b>SDR 21</b>									
TYPE OF SCREEN OR PERFORATION MATERIAL:									
1 Steel 3 Stainless steel 5 Fiberglass 7 PVC 10 Asbestos-cement									
2 Brass 4 Galvanized steel 6 Concrete tile 8 RMP (SR) 11 Other (specify) ....									
9 ABS 12 None used (open hole)									
SCREEN OR PERFORATION OPENINGS ARE:									
1 Continuous slot 3 Mill slot 5 Gauzed wrapped <u>8 Saw cut</u> 11 None (open hole)									
2 Louvered shutter 4 Key punched 6 Wire wrapped 9 Drilled holes									
7 Torch cut 10 Other (specify) ....									
SCREEN-PERFORATED INTERVALS: From <b>140</b> ft. to <b>180</b> ft. From .... ft. to .... ft.									
From .... ft. to .... ft. From .... ft. to .... ft.									
GRAVEL PACK INTERVALS: From <b>10</b> ft. to <b>180</b> ft. From .... ft. to .... ft.									
From .... ft. to .... ft. From .... ft. to .... ft.									
6 GROUT MATERIAL: 1 Neat cement 2 Cement grout <u>3 Bentonite</u> 4 Other									
Grout Intervals: From <b>0</b> ft. to <b>10</b> ft. From .... ft. to .... ft. From .... ft. to .... ft.									
What is the nearest source of possible contamination: <b>none</b>									
1 Septic tank 4 Lateral lines 7 Pit privy 10 Livestock pens 14 Abandoned water well									
2 Sewer lines 5 Cess pool 8 Sewage lagoon 11 Fuel storage 15 Oil well/Gas well									
3 Watertight sewer lines 6 Seepage pit 9 Feedyard 12 Fertilizer storage 16 Other (specify below)									
13 Insecticide storage									
Direction from well? How many feet?									
FROM TO LITHOLOGIC LOG FROM TO LITHOLOGIC LOG									
0 15 Dark topsoil & brown clay									
15 30 Medium sand & Clay									
30 150 Brown clay									
150 165 Sandstone layers									
165 180 Sandstone									
180 240 Sandstone layers & clay									
240 285 Red clay									
285 300 Brown sandstone									
7 CONTRACTOR'S OR LANDOWNER'S CERTIFICATION: This water well was (1) constructed, (2) reconstructed, or (3) plugged under my jurisdiction and was completed on (mo/day/year) <b>March 7, 1983</b> and this record is true to the best of my knowledge and belief. Kansas									
Water Well Contractor's License No. <b>179</b> This Water Well Record was completed on (mo/day/yr) <b>April 1, 1983</b>									
under the business name of <b>Joe's Well Service, Inc. Cimarron, Ks.</b> by (signature) <i>Larry Crick</i>									
INSTRUCTIONS: Use typewriter or ball point pen, PLEASE PRESS FIRMLY and PRINT clearly. Please fill in blanks, underline or circle the correct answers. Send top three copies to Kansas Department of Health and Environment, Division of Environment, Environmental Geology Section, Topeka, KS 66620. Send one to WATER WELL OWNER and retain one for your records.									