

1 LOCATION OF WATER WELL:		Fraction	Section Number	Township Number	Range Number
County:	Ford	SW ¼ SE ¼ NW ¼	25	T 27 S	R 21 E/W


1 LOCATION OF WATER WELL:		Fraction	Section Number	Township Number	Range Number
County:	Ford	SW ¼ SE ¼ NW ¼	25	T 27 S	R 21 E/W

Distance and direction from nearest town or city street address of well if located within city?

From Ford-Kiowa County Line - 3 miles North

2 WATER WELL OWNER:	Jerry Droste	WELL #3	
RR#, St. Address, Box # :	Box 1297		Board of Agriculture, Division of Water Resources
City, State, ZIP Code :	Dodge City, Kansas 67801		Application Number:

3 LOCATE WELL'S LOCATION WITH AN "X" IN SECTION BOX: 4 DEPTH OF COMPLETED WELL: 56 ft. ELEVATION:   
 Depth(s) Groundwater Encountered 1. ft. 2. ft. 3. ft.

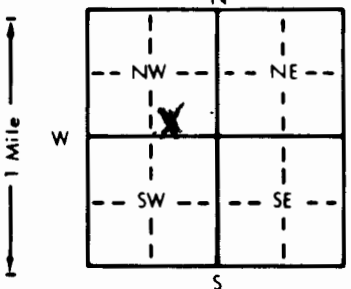

WELL'S STATIC WATER LEVEL . . . 29 . . . ft. below land surface measured on mo/day/yr . . . 5-8-91 . . .

Pump test data: Well water was . . . ft. after . . . hours pumping . . . gpm

Est. Yield . . . 12 . . . gpm: Well water was . . . ft. after . . . hours pumping . . . gpm

Bore Hole Diameter . . . 10 . . . in. to . . . 56 . . . ft., and . . . in. to . . . ft.

WELL WATER TO BE USED AS:

1 Domestic	3 Feedlot	6 Oil field water supply	9 Dewatering	11 Injection well
2 Irrigation	4 Industrial	7 Lawn and garden only	10 Monitoring well	12 Other (Specify below)

Was a chemical/bacteriological sample submitted to Department? Yes . . . No. x x . . . ; If yes, mo/day/yr sample was submitted

Water Well Disinfected? Yes x x No

5	TYPE OF BLANK CASING USED:		5 Wrought iron	8 Concrete tile	CASING JOINTS: Glued . X.X . . Clamped . . . . . Welded . . . . . Threaded . . . . .
	1 Steel	3 RMP (SR)	6 Asbestos-Cement	9 Other (specify below)	
	2 PVC	4 ABS	7 Fiberglass	.....	

Blank casing diameter . . . 5 . . . in. to . . . 56 . . . ft., Dia . . . in. to . . . ft., Dia . . . in. to . . . ft.  
Casing height above land surface . . . 12 . . . in., weight . . . 200 . . . psi . . . lbs./ft. Wall thickness or gauge No. . . SDR 21 . . .

TYPE OF SCREEN OR PERFORATION MATERIAL:			<u>7 PVC</u>	10 Asbestos-cement
1 Steel	3 Stainless steel	5 Fiberglass	8 RMP (SR)	11 Other (specify) . . . . .
2 Brass	4 Galvanized steel	6 Concrete tile	9 ABS	12 None used (open hole)

SCREEN OR PERFORATION OPENINGS ARE:		5 Gauzed wrapped	<u>8 Saw cut</u>	11 None (open hole)
1 Continuous slot	3 Mill slot	6 Wire wrapped	<u>9 Drilled holes</u>	

2 Louvered shutter		4 Key punched		7 Torch cut		10 Other (specify) .....	
SCREEN-PERFORATED INTERVALS:		From ..... 30 ..... ft. to ..... 50 ..... ft.,		From ..... ft. to ..... ft.,		From ..... ft. to ..... ft.	
		From ..... ft. to ..... ft.,		From ..... ft. to ..... ft.,		From ..... ft. to ..... ft.	
GRAVEL PACK INTERVALS:		From ..... 20 ..... ft. to ..... 56 ..... ft.,		From ..... ft. to ..... ft.,		From ..... ft. to ..... ft.	
		From ..... ft. to ..... ft.,		From ..... ft. to ..... ft.,		From ..... ft. to ..... ft.	
6 GROUT MATERIAL:		1 Neat cement		2 Cement grout		3 Bentonite	
		4 Other ..... hole plug .....					
Grout Intervals:		From ..... 0 ..... ft. to ..... 20 ..... ft.,		From ..... ft. to ..... ft.,		From ..... ft. to ..... ft.	
What is the nearest source of possible contamination:		none		10 Livestock pens		14 Abandoned water well	
1 Septic tank		4 Lateral lines		7 Pit privy		11 Fuel storage	
2 Sewer lines		5 Cess pool		8 Sewage lagoon		12 Fertilizer storage	
3 Watertight sewer lines		6 Seepage pit		9 Feedyard		13 Insecticide storage	
Direction from well?						How many feet?	

**RECEIVED**  
JUN 19 1991  
DIVISION OF  
ENVIRONMENT

FROM	TO	LITHOLOGIC LOG	FROM	TO	PLUGGING INTERVALS
0	20	Top soil & clay			