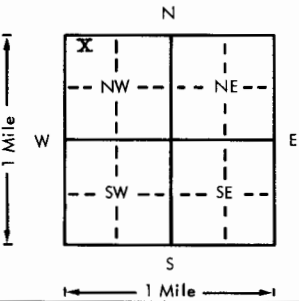
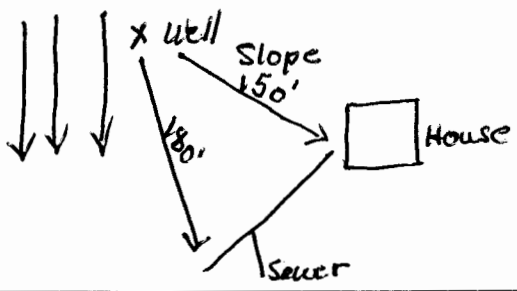


USE TYPEWRITER OR BALL
POINT PEN-PRESS FIRMLY,
PRINT CLEARLY.

WATER WELL RECORD
KSA 82a-1201-1215

Kansas Department of Health and
Environment-Division of Environment
(Water well Contractors)
Topeka, Kansas 66620

1. Location of well:		County Ford	Fraction NW 1/4 NW 1/4 NW 1/4	Section number 31	Township number T 27	Range number S R 21	E/W
2. Distance and direction from nearest town or city: 2 mi N & 6 mi East of Ford Street address of well location if in city:				3. Owner of well: Albert Miller R.R. or street: Buxklin City, state, zip code: Ks. 67834			
4. Locate with "X" in section below:		Sketch map:			6. Bore hole dia. 10 in. Completion date 6-30-77 Well depth 98 ft.		
					7. <input checked="" type="checkbox"/> Cable tool <input checked="" type="checkbox"/> Rotary <input type="checkbox"/> Driven <input type="checkbox"/> Dug <input type="checkbox"/> Hollow rod <input type="checkbox"/> Jetted <input type="checkbox"/> Bored <input type="checkbox"/> Reverse rotary		
5. Type and color of material		From	To	8. Use: <input checked="" type="checkbox"/> Domestic <input type="checkbox"/> Public supply <input type="checkbox"/> Industry <input type="checkbox"/> Irrigation <input type="checkbox"/> Air conditioning <input type="checkbox"/> Stock <input type="checkbox"/> Lawn <input type="checkbox"/> Oil field water <input type="checkbox"/> Other			
Clay; little sand		0	20	9. Casing: Material Plstc Height: Above or below Threaded <input type="checkbox"/> Welded <input checked="" type="checkbox"/> Surface 18 in. RMP <input type="checkbox"/> PVC <input type="checkbox"/> Weight <input type="checkbox"/> lbs./ft. Dia. 5 in. to 98 ft. depth Wall Thickness: inches or Dia. <input type="checkbox"/> in. to <input type="checkbox"/> ft. depth gage No. Sch 40			
Medium sand		20	40	10. Screen: Manufacturer's name Jesse-Lowell Type Plstc Schl 40 Dia. 5 in. Slot/gauze 1/16 Length 30 Set between 68 ft. and 98 ft. <input type="checkbox"/> ft. and <input type="checkbox"/> ft.			
Clay, little sandstone		40	60	Gravel pack? Yes Size range of material 3/16			
Good sandstone		60	95	11. Static water level: <input type="checkbox"/> mo./day/yr. 34 ft. below land surface Date 9-1-76			
Clay		95	97	12. Pumping level below land surfaces: 40 ft. after 1 1/2 hrs. pumping 50 g.p.m. <input type="checkbox"/> ft. after <input type="checkbox"/> hrs. pumping <input type="checkbox"/> g.p.m. Estimated maximum yield 50 g.p.m.			
				13. Water sample submitted: <input type="checkbox"/> Yes <input checked="" type="checkbox"/> No Date <input type="checkbox"/>			
				14. Well head completion: <input checked="" type="checkbox"/> Pitless adapter 24 inches above grade			
				15. Well grouted? Yes With: <input type="checkbox"/> Neat cement <input type="checkbox"/> Bentonite <input checked="" type="checkbox"/> Concrete Depth: From 4 ft. to 4 ft.			
				16. Nearest source of possible contamination: ft. 180 Direction SE Type Sewer Well disinfected upon completion? Yes Yes <input type="checkbox"/> No			
				17. Pump: Manufacturer's name Pumpco Model number 152S1011 HP 1 Volts 230 Length of drop pipe 80 ft. capacity 17 g.p.m. Type: <input checked="" type="checkbox"/> Submersible <input type="checkbox"/> Turbine <input type="checkbox"/> Jet <input type="checkbox"/> Reciprocating <input type="checkbox"/> Centrifugal <input type="checkbox"/> Other			
		(Use a second sheet if needed)					
18. Elevation:		19. Remarks:		20. Water well contractor's certification: This well was drilled under my jurisdiction and this report is true to the best of my knowledge and belief. High Plains Drilling & Supply, Inc 136B Business name 102 N 3rd, Garden City, Ks. License No. 6-30-77 Address Arthur B. Rukhman Date 6-30-77 Signed Authorized representative			
Topography: <input type="checkbox"/> Hill <input checked="" type="checkbox"/> Slope <input type="checkbox"/> Upland <input type="checkbox"/> Valley							