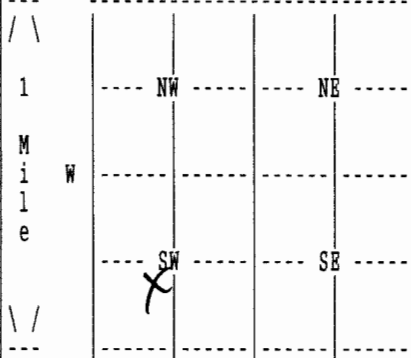


1 LOCATION OF WATER WELL: COUNTY: FORD	Fraction NE 1/4 SW 1/4 SW 1/4	Section Number 34	Township Number T 27 S	Range Number R 21 W
---	----------------------------------	----------------------	---------------------------	------------------------

Distance and direction from nearest town or city street address of well if located within city?

6 MILES NORTH, 2 MILES EAST OF BUCKLIN

2 WATER WELL OWNER: RR#, St. Address, Box # : City, State, ZIP code :	GILES RANCH PO BOX 1000 ASHLAND, KS 67831-	Board of Agriculture, Division of Water Resources Application Number:
---	--	--

3 LOCATE WELL'S LOCATION WITH
AN "X" IN SECTION BOX:4 DEPTH OF COMPLETED WELL 31 ELEVATION: 0
Depth(s) Groundwater Encountered 1. 0 ft. 2. 0 ft. 3. 0 ft.WELL'S STATIC WATER LEVEL 22 ft. below land surface measured on mo/day/yr 04/21/05
Pump test data: Well water was 0 ft. after 0 hours pumping 0 gpm

Estimated Yield 0 gpm: Well water was 0 ft. after 0 hours pumping 0 gpm

Bore Hole Diameter 8.75 in. to 31 ft., and in. to 0 ft.

WELL WATER TO BE USED AS: LIVESTOCK

Was a chemical/bacteriological sample submitted to department? No ;
If yes, mo/day/yr sample was submitted Water well disinfected? Yes

5 TYPE OF BLANK CASING USED: PVC	CASING JOINTS: GLUED
Blank casing diameter 5 in. to 21 ft., Dia	in. to 0 ft., Dia in. to 0 ft.
Casing height above land surface 12 in., weight	0 lbs/ft. Wall thickness or gauge No. 26
TYPE OF SCREEN OR PERFORATION MATERIAL: PVC	
SCREEN OR PERFORATION OPENINGS ARE:	SAW CUT

SCREEN PERFORATED INTERVALS:	From 21 ft. to 31 ft., From 0 ft. to 0 ft.
	From 0 ft. to 0 ft., From 0 ft. to 0 ft.
GRAVEL PACK INTERVALS:	From 20 ft. to 31 ft., From 0 ft. to 0 ft.
	From 0 ft. to 0 ft., From 0 ft. to 0 ft.

6 GROUT MATERIAL BENTONITE
Grout Intervals: From 0 ft. to 20 ft., From 0 ft. to 0 ft., From 0 ft. to 0 ft.

What is the nearest source of possible contamination: SEPTIC TANK

Direction from well? SOUTHEAST

How many feet? 8000

FROM	TO	LITHOLOGIC LOG	FROM	TO	PLUGGING INTERVALS
0	8	SILT AND SAND			
8	27	SAND AND GRAVEL			
27	31	TAN CLAY			

7 CONTRACTOR'S OR LANDOWNER'S CERTIFICATION: This water well was Constructed under my jurisdiction and was completed on (mo/day/year) 04/21/05 and this record is true to the best of my knowledge and belief. Kansas Water Well Contractor's License No. 653 This Water Well Record was completed on (mo/day/yr) 06/24/05 under the business name of DAN HAYSE WATER WELL SERV by (signature) Dan Hayse