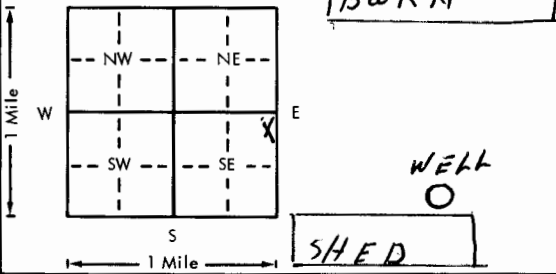


USE TYPEWRITER OR BALL  
POINT PEN-PRESS FIRMLY,  
PRINT CLEARLY.

WATER WELL RECORD  
KSA 82a-1201-1215

Kansas Department of Health and  
Environment-Division of Environment  
(Water well Contractors)  
Topeka, Kansas 66620

1. Location of well:		County <b>Ford</b>	Fraction <b>NE 1/4 NE 1/4 SE 1/4</b>	Section number <b>12</b>	Township number <b>T 27 S R 22 E/W</b>	Range number
2. Distance and direction from nearest town or city:		1 N, 4 E, 3 1/2 miles				
Street address of well location if in city:		North of Ford, Kansas				
Owner of well:		Grant Powers				
R.R. or street:		City, state, zip code: <b>Spearville, Kansas 67876</b>				
4. Locate with "X" in section below:		Sketch map:		6. Bore hole dia. <b>8</b> in. Completion date <b>9-19-77</b> Well depth <b>240</b> ft.		
				7. <input checked="" type="checkbox"/> Cable tool <input checked="" type="checkbox"/> Rotary <input type="checkbox"/> Driven <input type="checkbox"/> Dug <input type="checkbox"/> Hollow rod <input type="checkbox"/> Jetted <input type="checkbox"/> Bored <input type="checkbox"/> Reverse rotary		
5. Type and color of material		From		To		8. Use: <input checked="" type="checkbox"/> Domestic <input type="checkbox"/> Public supply <input type="checkbox"/> Industry <input type="checkbox"/> Irrigation <input type="checkbox"/> Air conditioning <input type="checkbox"/> Stock <input type="checkbox"/> Lawn <input type="checkbox"/> Oil field water <input type="checkbox"/> Other
Top soil & clay		15		30		9. Casing: Material <b>RMP</b> Height: Above or below Threaded <input type="checkbox"/> Welded <input type="checkbox"/> Surface <b>12</b> in. RMP <b>XX</b> PVC <input type="checkbox"/> Weight <input type="checkbox"/> lbs./ft. Dia. <b>5</b> in. to <b>240</b> ft. depth Wall Thickness: inches or Dia. <input type="checkbox"/> in. to <input type="checkbox"/> ft. depth gage No. <b>250</b>
Clay & fine sand		30		45		10. Screen: Manufacturer's name <b>Sunflower</b> Type <b>RMP</b> Dia. <b>5"</b> Slot <b>1/8"</b> Length <b>20</b> ft. Set between <b>40</b> ft. and <b>80</b> ft. <b>120</b> ft. and <b>240</b> ft. Gravel pack? <b>yes</b> Size range of material <b>1/4"</b>
Clay (lost circulation)		45		60		11. Static water level: <input type="checkbox"/> mo./day/yr. <b>36</b> ft. below land surface Date <b>9-19-77</b>
Lost circulation		60		200		12. Pumping level below land surfaces: <b>150</b> ft. after <b>1</b> hrs. pumping <b>20</b> g.p.m. ft. after <input type="checkbox"/> hrs. pumping <input type="checkbox"/> g.p.m. Estimated maximum yield <b>20</b> g.p.m.
Blue shale & layers of sand stone		200		240		13. Water sample submitted: <input type="checkbox"/> Yes <input checked="" type="checkbox"/> No Date <input type="checkbox"/>
						14. Well head completion: <input checked="" type="checkbox"/> Pitless adapter <b>12</b> inches above grade
						15. Well grouted? <b>yes</b> With: <input checked="" type="checkbox"/> Neat cement <input type="checkbox"/> Bentonite <input type="checkbox"/> Concrete Depth: From <b>7</b> ft. to <b>20</b> ft.
						16. Nearest source of possible contamination: ft. <b>200</b> Direction <b>North</b> Type <b>Barn Yard</b> Well disinfected upon completion? <input checked="" type="checkbox"/> Yes <input type="checkbox"/> No
						17. Pump: Not installed Manufacturer's name <b>Goulds</b> Model number <b>13EM</b> HP <b>1</b> Volts <b>230</b> Length of drop pipe <b>189</b> ft. capacity <b>13</b> g.p.m. Type: <input checked="" type="checkbox"/> Submersible <input type="checkbox"/> Turbine <input type="checkbox"/> Jet <input type="checkbox"/> Reciprocating <input type="checkbox"/> Centrifugal <input type="checkbox"/> Other
						20. Water well contractor's certification: This well was drilled under my jurisdiction and this report is true to the best of my knowledge and belief. <b>Joe's Well Service</b> <b>179</b> Business name License No. Address <b>Box 174 Cimarron, Ks.</b> Signed <b>Larry J. Crick</b> Date <b>9-28-77</b> Authorized representative
18. Elevation:		19. Remarks:				
Topography: <input type="checkbox"/> Hill <input type="checkbox"/> Slope <input checked="" type="checkbox"/> Upland <input type="checkbox"/> Valley						

27  
220  
12  
1/4 1/4 1/4  
NENESE