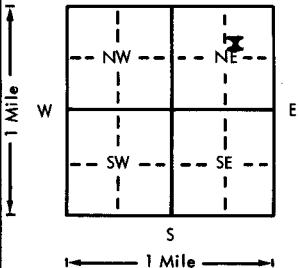
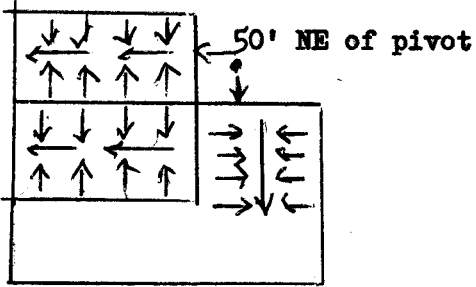


USE TYPEWRITER OR BALL
POINT PEN-PRESS FIRMLY,
PRINT CLEARLY.

WATER WELL RECORD
KSA 82a-1201-1215

Kansas Department of Health and
Environment-Division of Environment
(Water well Contractors)
Topeka, Kansas 66620

1. Location of well:		County Ford	Fraction SW 1/4 NE 1/4 NE 1/4	Section number 29	Township number 27	Range number S R 22 E/W
2. Distance and direction from nearest town or city: 1 1/4 mi North of Bord Ks. Street address of well location if in city:				3. Owner of well Ford Land & Cattle Company R.R. or street: City, state, zip code: Ford, Ks. 67842		
4. Locate with "X" in section below:		Sketch map:		6. Bore hole dia. 26 in. Completion date 6-10-75 Well depth 136 ft.		
				7. <input checked="" type="checkbox"/> Cable tool <input checked="" type="checkbox"/> Rotary <input type="checkbox"/> Driven <input type="checkbox"/> Dug <input type="checkbox"/> Hollow rod <input type="checkbox"/> Jetted <input type="checkbox"/> Bored <input type="checkbox"/> Reverse rotary		
5. Type and color of material				From	To	8. Use: <input checked="" type="checkbox"/> Domestic <input type="checkbox"/> Public supply <input type="checkbox"/> Industry <input checked="" type="checkbox"/> Irrigation <input type="checkbox"/> Air conditioning <input type="checkbox"/> Stock <input type="checkbox"/> Lawn <input type="checkbox"/> Oil field water <input type="checkbox"/> Other
Clay, gyp				0	35	9. Casing: Material Steel Height: Above or below Threaded <input type="checkbox"/> Welded <input checked="" type="checkbox"/> Surface 12 in. RMP <input type="checkbox"/> PVC <input type="checkbox"/> Weight 36.86 lbs./ft. Dia 26 in. to 136 ft. depth Wall Thickness: inches or Dia. <input type="checkbox"/> in. to <input type="checkbox"/> ft. depth gage No. 219 W
Sandstone				35	135	10. Screen: Manufacturer's name Lakewood Miller Gearhead & Pump Repair Type Millplot Dia. 16 Slot/gauze 1/8 Length 2" Set between 56 ft. and 136 ft. ft. and <input type="checkbox"/> ft.
Clay, shale				135	160	Gravel pack <input checked="" type="checkbox"/> Size range of material 1/2 x 5/8
						11. Static water level: <input type="checkbox"/> mo./day/yr. 48 ft. below land surface Date 10-6-75
						12. Pumping level below land surfaces: 48 ft. after 5 hrs. pumping 400 g.p.m. ft. after <input type="checkbox"/> hrs. pumping <input type="checkbox"/> g.p.m. Estimated maximum yield 400 g.p.m.
						13. Water sample submitted: <input type="checkbox"/> Yes <input checked="" type="checkbox"/> No Date <input type="checkbox"/>
						14. Well head completion: <input type="checkbox"/> Pitless adapter 12 inches above grade
						15. Well grouted? Yes With: <input checked="" type="checkbox"/> Neat cement <input type="checkbox"/> Bentonite <input type="checkbox"/> Concrete Depth: From 0 ft. to 10 ft.
						16. Nearest source of possible contamination: ft. 50' Direction E & N of feedlot Well disinfected upon completion? <input type="checkbox"/> Yes <input checked="" type="checkbox"/> No
						17. Pump: <input type="checkbox"/> Not installed Manufacturer's name Worthington Model number 8-121-40 HP <input type="checkbox"/> Volts <input type="checkbox"/> Length of drop pipe 133 ft. capacity 500 g.p.m. Type: <input type="checkbox"/> Submersible <input checked="" type="checkbox"/> Turbine <input type="checkbox"/> Jet <input type="checkbox"/> Reciprocating <input type="checkbox"/> Centrifugal <input type="checkbox"/> Other
(Use a second sheet if needed)						
18. Elevation:		19. Remarks:		20. Water well contractor's certification: This well was drilled under my jurisdiction and this report is true to the best of my knowledge and belief. High Plains Drilling & Supply, Inc 136 Business name 402 N 3rd, Garden City, Ks. License No. 11/3/75 Address Wade L. Markens Date Signed Sept 1975 Representative		