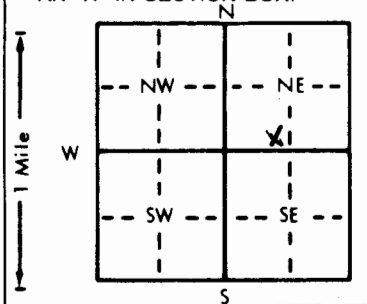


1 LOCATION OF WATER WELL: County: <u>Ford</u>	Fraction <u>SE 1/4 SW 1/4 NE 1/4</u>	Section Number <u>30</u>	Township Number T <u>27</u> S	Range Number R <u>23</u> E <u>(W)</u>
--	---	-----------------------------	----------------------------------	--

Distance and direction from nearest town or city street address of well if located within city?

From Wilroads Gardens, 1 mile east, 2 miles south, 1 1/4 miles east, then 3/4 mile south

2 WATER WELL OWNER: RR#, St. Address, Box # : <u>Kevin Youngers</u> City, State, ZIP Code : <u>12006 Harriet Way</u> <u>Dodge City, Ks. 67801</u>	Board of Agriculture, Division of Water Resources Application Number:
--	--

3 LOCATE WELL'S LOCATION WITH AN "X" IN SECTION BOX: 	4 DEPTH OF COMPLETED WELL: <u>210</u> ft. ELEVATION: Depth(s) Groundwater Encountered 1. ft. 2. ft. 3. ft. WELL'S STATIC WATER LEVEL <u>64</u> ft. below land surface measured on mo/day/yr <u>5-24-97</u> Pump test data: Well water was ft. after hours pumping gpm Est. Yield gpm Well water was ft. after hours pumping gpm Bore Hole Diameter <u>9 7/8</u> in. to ft., and in. to ft. WELL WATER TO BE USED AS: 5 Public water supply 8 Air conditioning 11 Injection well <u>Domestic</u> 3 Feedlot 6 Oil field water supply 9 Dewatering 12 Other (Specify below) 2 Irrigation 4 Industrial 7 Lawn and garden only 10 Monitoring well Was a chemical/bacteriological sample submitted to Department? Yes No <u>X</u> If yes, mo/day/yr sample was submitted Water Well Disinfected? Yes <u>X</u> No
--	---

5 TYPE OF BLANK CASING USED: 1 Steel 3 RMP (SR) 5 Wrought iron 8 Concrete tile CASING JOINTS: Glued <u>X</u> Clamped <u>2 PVC</u> 4 ABS 6 Asbestos-Cement 9 Other (specify below) Welded 7 Fiberglass Threaded Blank casing diameter <u>5</u> in. to <u>190</u> ft., Dia. in. to ft., Dia. in. to ft. Casing height above land surface <u>12</u> in., weight lbs./ft. Wall thickness or gauge No. <u>SOR 21</u> TYPE OF SCREEN OR PERFORATION MATERIAL: 1 Steel 3 Stainless steel 5 Fiberglass 8 RMP (SR) 10 Asbestos-cement 2 Brass 4 Galvanized steel 6 Concrete tile 9 ABS 11 Other (specify) 12 None used (open hole) SCREEN OR PERFORATION OPENINGS ARE: 1 Continuous slot 3 Mill slot 5 Gauzed wrapped 8 Saw cut 11 None (open hole) 2 Louvered shutter 4 Key punched 6 Wire wrapped 9 Drilled holes 7 Torch cut 10 Other (specify) SCREEN-PERFORATED INTERVALS: From <u>190</u> ft. to <u>210</u> ft., From ft. to ft. From ft. to ft., From ft. to ft. GRAVEL PACK INTERVALS: From <u>20</u> ft. to <u>210</u> ft., From ft. to ft. From ft. to ft., From ft. to ft.

6 GROUT MATERIAL: 1 Neat cement 2 Cement grout <u>Bentonite</u> 4 Other Grout Intervals: From <u>0</u> ft. to <u>20</u> ft., From ft. to ft., From ft. to ft. What is the nearest source of possible contamination: 1 Septic tank 4 Lateral lines 7 Pit privy 10 Livestock pens 14 Abandoned water well 2 Sewer lines 5 Cess pool 8 Sewage lagoon 11 Fuel storage 15 Oil well/Gas well 3 Watertight sewer lines 6 Seepage pit 9 Feedyard 12 Fertilizer storage 16 Other (specify below) 13 Insecticide storage <u>In Pasture</u> Direction from well? How many feet?

FROM	TO	LITHOLOGIC LOG	FROM	TO	PLUGGING INTERVALS
0	4	Sandy Topsoil			
4	40	Brown clay			
40	85	Med. sand & brown sandy clay			
85	135	Med. sand			
135	162	Brown clay			
162	210	Med. sand			

7 CONTRACTOR'S OR LANDOWNER'S CERTIFICATION: This water well was (1) constructed, (2) reconstructed, or (3) plugged under my jurisdiction and was completed on (mo/day/year) <u>5-24-97</u> and this record is true to the best of my knowledge and belief. Kansas Water Well Contractor's License No. <u>533</u> This Water Well Record was completed on (mo/day/yr) <u>9-22-97</u> under the business name of <u>Santzen Water Well Repair</u> by (signature) <u>[Signature]</u>
--