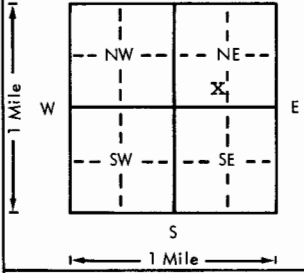


USE TYPEWRITER OR BALL
POINT PEN-PRESS FIRMLY,
PRINT CLEARLY.

WATER WELL RECORD
KSA 82a-1201-1215

Kansas Department of Health and
Environment-Division of Environment
(Water well Contractors)
Topeka, Kansas 66620

1. Location of well:	County Ford	Fraction NE SE 1/4 SW 1/4 NE 1/4	Section number 11	Township number T 27 S	Range number R 23 E
2. Distance and direction from nearest town or city: 12 miles SE of Dodge City Street address of well location if in city:			3. Owner of well: Paul Kisslinger R.R. or street: Route 1 City, state, zip code: Larned, KS 67550		
4. Locate with "X" in section below: 			Sketch map:		
5. Type and color of material			From	To	6. Bore hole dia. 24 in. Completion date 8-30-77 Well depth 52 ft.
top soil			0	4	7. <input type="checkbox"/> Cable tool <input type="checkbox"/> Rotary <input type="checkbox"/> Driven <input type="checkbox"/> Dug <input type="checkbox"/> Hollow rod <input type="checkbox"/> Jetted <input checked="" type="checkbox"/> Bored <input checked="" type="checkbox"/> Reverse rotary
sandy clay, limestone, white clay			4	30	8. Use: <input type="checkbox"/> Domestic <input type="checkbox"/> Public supply <input type="checkbox"/> Industry <input checked="" type="checkbox"/> Irrigation <input type="checkbox"/> Air conditioning <input type="checkbox"/> Stock <input type="checkbox"/> Lawn <input type="checkbox"/> Oil field water <input type="checkbox"/> Other
sand, gravel loose limestone			30	32	9. Casing: Material Steel Height 12 in. Above or below Threaded <input type="checkbox"/> Welded <input checked="" type="checkbox"/> Surface 16 in. RMP 16 38 38 Weight 3.03 lbs./ft. Dia. 16 in. to 52 ft. depth Wall Thickness: inches or Dia. 16 in. to 52 ft. depth gauge No. 7 ga.
hard cemented gravel			32	40	10. Screen: Manufacturer's name Cook Type Double-slot Dia. 16" Slot/gauze 1/8 Length 10' Set between 38 ft. and 48 ft. Gravel pack? yes Size range of material 3/8-200
good sand gravel			40	47	11. Static water level: 27' ft. below land surface Date 8-30-77 mo./day/yr.
blue shale, brown clay			47	52	12. Pumping level below land surfaces: NC ft. after hrs. pumping g.p.m. ft. after hrs. pumping g.p.m. Estimated maximum yield g.p.m.
					13. Water sample submitted: mo./day/yr. Yes <input type="checkbox"/> No <input checked="" type="checkbox"/> Date
					14. Well head completion: Pitless adapter 12 inches above grade
					15. Well grouted? yes With: <input checked="" type="checkbox"/> Neat cement <input type="checkbox"/> Bentonite <input type="checkbox"/> Concrete Depth: From 0 ft. to 10 ft.
					16. Nearest source of possible contamination: FIELD ft. Direction Type Well disinfected upon completion? Yes <input type="checkbox"/> No <input checked="" type="checkbox"/>
					17. Pump: Not installed Manufacturer's name Peerless Pump Model number 10LB-6 HP 30 Volts 460 Length of drop pipe 45 ft. capacity 400 g.p.m. Type: <input type="checkbox"/> Submersible <input checked="" type="checkbox"/> Turbine <input type="checkbox"/> Jet <input type="checkbox"/> Reciprocating <input type="checkbox"/> Centrifugal <input type="checkbox"/> Other
(Use a second sheet if needed)					
18. Elevation:	19. Remarks:		20. Water well contractor's certification: This well was drilled under my jurisdiction and this report is true to the best of my knowledge and belief. Clarke Well & Equip., Inc. 185 Business name Great Bend KS 67530 Address Signed [Signature] Date 11/1/77 Authorized representative		

Forward the white, blue and pink copies to the Department of Health and Environment

Form WWC-5