


1 LOCATION OF WATER WELL: Fraction **SW 1/4 SE 1/4 NW 1/4** Section Number **18** Township Number **T 27 S** Range Number **R 23 E/W**
 County: **Ford**

Distance and direction from nearest town or city street address of well if located within city?
Located at Wilroads, Kansas

2 WATER WELL OWNER: **Kelly Dowling**
 RR#, St. Address, Box #: **RD #3** Board of Agriculture, Division of Water Resources
 City, State, ZIP Code: **Dodge City, Kansas 67801** Application Number: **---**

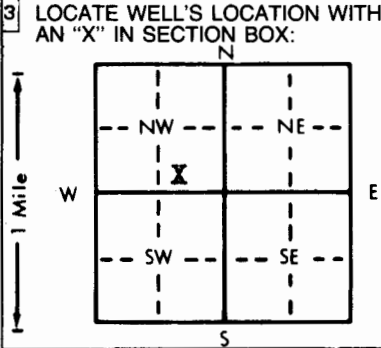

4 DEPTH OF COMPLETED WELL: **133** ft. ELEVATION: **Upland**
 Depth(s) Groundwater Encountered 1. **30** ft. 2. **90** ft. 3. **120** ft.
 WELL'S STATIC WATER LEVEL **7** ft. below land surface measured on mo/day/yr **April 8, 1982**
 Pump test data: Well water was _____ ft. after _____ hours pumping _____ gpm
 Est. Yield **100** gpm: Well water was _____ ft. after _____ hours pumping _____ gpm
 Bore Hole Diameter **10** in. to **133** ft., and _____ in. to _____ ft.
 WELL WATER TO BE USED AS:
 5 Public water supply 8 Air conditioning 11 Injection well
 3 Feedlot 6 Oil field water supply 9 Dewatering 12 Other (Specify below)
 2 Irrigation 4 Industrial 7 Lawn and garden only 10 Observation well
 Was a chemical/bacteriological sample submitted to Department? Yes _____ No **XX**; If yes, mo/day/yr sample was submitted
 Water Well Disinfected? Yes **XX** No

5 TYPE OF BLANK CASING USED:
 1 Steel **XXX** PVC 3 RMP (SR) 4 ABS 5 Wrought iron 6 Asbestos-Cement 7 Fiberglass 8 Concrete tile 9 Other (specify below) CASING JOINTS: Glued **XX** Clamped _____
 Blank casing diameter **5** in. to **83** ft., Dia _____ in. to _____ ft., Dia _____ in. to _____ ft.
 Casing height above land surface **12** in., weight **2.8** lbs./ft. Wall thickness or gauge No. **.265**
 TYPE OF SCREEN OR PERFORATION MATERIAL:
 XXX PVC 10 Asbestos-cement 11 Other (specify) _____
 1 Steel 3 Stainless steel 5 Fiberglass 8 RMP (SR)
 2 Brass 4 Galvanized steel 6 Concrete tile 9 ABS 12 None used (open hole)
 SCREEN OR PERFORATION OPENINGS ARE:
 5 Gauzed wrapped **XX** Saw cut 11 None (open hole)
 1 Continuous slot 3 Mill slot 6 Wire wrapped 9 Drilled holes
 2 Louvered shutter 4 Key punched 7 Torch cut 10 Other (specify) _____
 SCREEN-PERFORATED INTERVALS: From **83** ft. to **133** ft., From _____ ft. to _____ ft.
 GRAVEL PACK INTERVALS: From **14** ft. to **133** ft., From _____ ft. to _____ ft.

6 GROUT MATERIAL: **XX** Neat cement 2 Cement grout 3 Bentonite 4 Other _____
 Grout Intervals: From **4** ft. to **14** ft., From _____ ft. to _____ ft., From _____ ft. to _____ ft.
 What is the nearest source of possible contamination:
 XX Septic tank 4 Lateral lines 7 Pit privy 10 Livestock pens 14 Abandoned water well
 2 Sewer lines 5 Cess pool 8 Sewage lagoon 11 Fuel storage 15 Oil well/Gas well
 3 Watertight sewer lines 6 Seepage pit 9 Feedyard 12 Fertilizer storage 16 Other (specify below)
 13 Insecticide storage _____
 Direction from well? **East** How many feet? **100**

FROM	TO	LITHOLOGIC LOG	FROM	TO	LITHOLOGIC LOG
0	1	Topsoil			
1	3	Fine Sand			
3	8	Clay			
8	20	Med. to Lar. Sand & Gravel			
20	30	Clay			
30	90	Fine Sand w/Strips of Clay			
90	100	Med. to Lar. Sand & Gravel			
100	120	Clay w/Strips Fine Sand			
120	127	Med. to Lar. Sand			
127	140	Black Shale			

7 CONTRACTOR'S OR LANDOWNER'S CERTIFICATION: This water well was (1) constructed, (2) reconstructed, or (3) plugged under my jurisdiction and was completed on (mo/day/year) **April 20, 1982** and this record is true to the best of my knowledge and belief. Kansas Water Well Contractor's License No. **252** This Water Well Record was completed on (mo/day/year) **April 23, 1982** under the business name of **Friesen Windmill & Supply, Inc.** by (signature) *[Signature]*

INSTRUCTIONS: Use typewriter or ball point pen, PLEASE PRESS FIRMLY and PRINT clearly. Please fill in blanks, underline or circle the correct answers. Send top three copies to Kansas Department of Health and Environment, Division of Environment, Environmental Geology Section, Topeka, KS 66620. Send one to WATER WELL OWNER and retain one for your records.