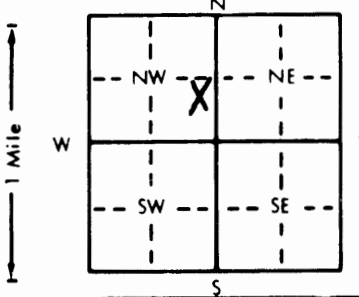


1 LOCATION OF WATER WELL:		Fraction	Section Number	Township Number	Range Number
County: Ford		NE 1/4 SE 1/4 NW 1/4	3	T 27 S	R 24 E (N)
Distance and direction from nearest town or city street address of well if located within city?					
101 Pershing Ave. Fort Dodge KS					
2 WATER WELL OWNER: Kansas Soldiers Home					
RR#, St. Address, Box # : 101 Pershing Ave. Board of Agriculture, Division of Water Resources					
City, State, ZIP Code : Fort Dodge Ks 67843 Application Number:					
3 LOCATE WELL'S LOCATION WITH AN "X" IN SECTION BOX:		4 DEPTH OF COMPLETED WELL 29.0' ft. ELEVATION: 100.07'			
		Depth(s) Groundwater Encountered 1. 21.0' ft. 2. ft. 3. ft.			
		WELL'S STATIC WATER LEVEL 22.23' ft. below land surface measured on mo/day/yr 08-06-91			
		Pump test data: Well water was ft. after hours pumping gpm			
		Est. Yield gpm: Well water was ft. after hours pumping gpm			
Bore Hole Diameter 8" in. to ft. and in. to ft.		WELL WATER TO BE USED AS:			
1 Domestic 3 Feedlot 6 Oil field water supply 9 Dewatering 12 Other (Specify below)		5 Public water supply 8 Air conditioning 11 Injection well			
2 Irrigation 4 Industrial 7 Lawn and garden only 10 Monitoring well					
Was a chemical/bacteriological sample submitted to Department? Yes No XX; If yes, mo/day/yr sample was submitted					
Water Well Disinfected? Yes No XX					
5 TYPE OF BLANK CASING USED:					
1 Steel 3 RMP (SR) 5 Wrought iron 8 Concrete tile CASING JOINTS: Glued Clamped					
2 PVC 4 ABS 6 Asbestos-Cement 9 Other (specify below) Welded					
3 Fiberglass Threaded Flush Jointed					
Blank casing diameter 2" in. to ft. Dia in. to ft. Dia in. to ft.					
Casing height above land surface in. weight .703 lbs./ft. Wall thickness or gauge No. .154					
TYPE OF SCREEN OR PERFORATION MATERIAL:					
1 Steel 3 Stainless steel 5 Fiberglass 8 RMP (SR) 10 Asbestos-cement					
2 Brass 4 Galvanized steel 6 Concrete tile 9 ABS 11 Other (specify)					
12 None used (open hole)					
SCREEN OR PERFORATION OPENINGS ARE:					
1 Continuous slot 3 Mill slot 5 Gauzed wrapped 8 Saw cut 11 None (open hole)					
2 Louvered shutter 4 Key punched 6 Wire wrapped 9 Drilled holes					
7 Torch cut 10 Other (specify)					
SCREEN-PERFORATED INTERVALS: From 8.75' ft. to 28.75' ft. From ft. to ft.					
From ft. to ft. From ft. to ft.					
GRAVEL PACK INTERVALS: From 6.0' ft. to 28.75' ft. From ft. to ft.					
From ft. to ft. From ft. to ft.					
6 GROUT MATERIAL: 1 Neat cement 2 Cement grout 3 Bentonite 4 Other					
Grout Intervals: From 1.0' ft. to 6.0' ft. From ft. to ft. From ft. to ft.					
What is the nearest source of possible contamination:					
1 Septic tank 4 Lateral lines 7 Pit privy 10 Livestock pens 14 Abandoned water well					
2 Sewer lines 5 Cess pool 8 Sewage lagoon 11 Fuel storage 15 Oil well/Gas well					
3 Watertight sewer lines 6 Seepage pit 9 Feedyard 12 Fertilizer storage 16 Other (specify below)					
13 Insecticide storage					
Direction from well? Southwest How many feet? 75'					
LITHOLOGIC LOG					
FROM	TO	LITHOLOGIC LOG			
FROM	TO	PLUGGING INTERVALS			
0.0'	11.0'	Topsoil, silt.			
11.0'	12.5'	Silt, clayey with fine sand.			
12.5'	21.0'	Sand, fine to coarse grain, poorly sorted.			
21.0'	26.0'	Sand, fine to coarse grain, poorly sorted, black stain.			
26.0'	29.0'	Ogallala.			
7 CONTRACTOR'S OR LANDOWNER'S CERTIFICATION: This water well was (1) constructed, (2) reconstructed, or (3) plugged under my jurisdiction and was completed on (mo/day/year) .07-09-91 and this record is true to the best of my knowledge and belief. Kansas Water Well Contractor's License No. 531 This Water Well Record was completed on (mo/day/yr) 08-13-91 under the business name of Geotechnical Services, Inc. by (signature) Allison J. Swain					
INSTRUCTIONS: Use typewriter or ball point pen. PLEASE PRESS FIRMLY and PRINT clearly. Please fill in blanks, underline or circle the correct answers. Send top three copies to Kansas Department of Health and Environment, Bureau of Water, Topeka, Kansas 66620-0001. Telephone: 913-296-5545. Send one to WATER WELL OWNER and retain one for your records.					