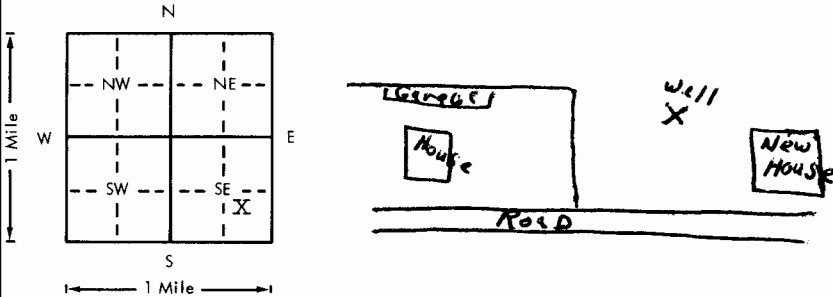


USE TYPEWRITER OR BALL
POINT PEN-PRESS FIRMLY,
PRINT CLEARLY.

WATER WELL RECORD
KSA 82a-1201-1215

Kansas Department of Health and
Environment-Division of Environment
(Water well Contractors)
Topeka, Kansas 66620

1. Location of well:		County Ford	Fraction NW 1/4 SE 1/4 SE 1/4	Section number 3 track 6	Township number T 27	Range number S R 24 W E/W
2. Distance and direction from nearest town or city: 5 miles East of Dodge City, Ks. in Street address of well location if in city: Wilroads Garden				3. Owner of well: R. L. Steininger R.R. or street: RR# 3 City, state, zip code: Dodge City, Kansas 67801		
4. Locate with "X" in section below:		Sketch map:		6. Bore hole dia. 9.75 in. Completion date Well depth 154 ft. 3-19-77		
				7. <input checked="" type="checkbox"/> Cable tool <input checked="" type="checkbox"/> Rotary <input type="checkbox"/> Driven <input type="checkbox"/> Dug <input type="checkbox"/> Hollow rod <input type="checkbox"/> Jetted <input type="checkbox"/> Bored <input type="checkbox"/> Reverse rotary		
5. Type and color of material				8. Use: <input checked="" type="checkbox"/> Domestic <input type="checkbox"/> Public supply <input type="checkbox"/> Industry <input type="checkbox"/> Irrigation <input type="checkbox"/> Air conditioning <input type="checkbox"/> Stock <input type="checkbox"/> Lawn <input type="checkbox"/> Oil field water <input type="checkbox"/> Other		
				9. Casing: Material pits Height: Above or below Threaded <input type="checkbox"/> Welded <input checked="" type="checkbox"/> Surface 18 in. RMP <input checked="" type="checkbox"/> PVC <input type="checkbox"/> Weight 1.8 lbs./ft. Dia. 5 in. to 154 ft. depth Wall Thickness: inches or Dia. <input type="checkbox"/> in. to <input type="checkbox"/> ft. depth gage No. 0.250		
				10. Screen: Manufacturer's name Jess and Lowell Type RMP Dia. 5 in. Slot/gauze .06 Length 40 ft. Set between 114 ft. and 154 ft. ft. and <input type="checkbox"/> ft. Gravel pack? yes Size range of material 1/8		
				11. Static water level: 23 ft. below land surface Date 3-18-77 mo./day/yr.		
				12. Pumping level below land surfaces: 30 ft. after 5 hrs. pumping 30 g.p.m. ft. after <input type="checkbox"/> hrs. pumping <input type="checkbox"/> g.p.m. Estimated maximum yield 30 g.p.m.		
				13. Water sample submitted: mo./day/yr. <input type="checkbox"/> Yes <input checked="" type="checkbox"/> No Date		
				14. Well head completion: <input checked="" type="checkbox"/> Pitless adapter 18 inches above grade		
				15. Well grouted? yes With: <input checked="" type="checkbox"/> Neat cement <input type="checkbox"/> Bentonite <input type="checkbox"/> Concrete Depth: From 4 ft. to 28 ft.		
				16. Nearest source of possible contamination: nc mm ft. 400 Direction west Type septic tank Well disinfected upon completion? <input checked="" type="checkbox"/> Yes <input type="checkbox"/> No		
				17. Pump: <input type="checkbox"/> Not installed Manufacturer's name Reda Model number 4D18PI51 HP 1 1/2 Volts 220 Length of drop pipe 88 ft. capacity 30 g.p.m. Type: <input checked="" type="checkbox"/> Submersible <input type="checkbox"/> Turbine <input type="checkbox"/> Jet <input type="checkbox"/> Reciprocating <input type="checkbox"/> Centrifugal <input type="checkbox"/> Other		
18. Elevation:		19. Remarks:		20. Water well contractor's certification: This well was drilled under my jurisdiction and this report is true to the best of my knowledge and belief. Hodde Drilling Co 302 Business name RR#1 Dodge City, Kansas Address RR#1 Dodge City, Kansas Signed Walter Hodde Jr. Date 4-2-77 Authorized representative		

Forward the white, blue and pink copies to the Department of Health and Environment

Form WWC-5