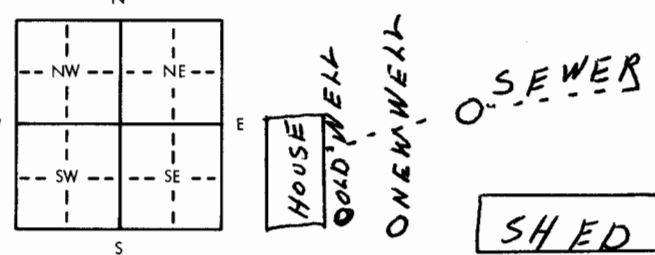


USE TYPEWRITER OR BALL
POINT PEN-PRESS FIRMLY,
PRINT CLEARLY.

WATER WELL RECORD
KSA 82a-1201-1215

Kansas Department of Health and
Environment-Division of Environment
(Water well Contractors)
Topeka, Kansas 66620

X Location of well:		County Ford	Fraction SW 1/4 SW 1/4 NE 1/4	Section number 10	Township number T 29 S R 24 W	Range number
2. Distance and direction from nearest town or city: Street address of well location if in city: Tract 93, Wilroads Garden, Ks.			3. Owner of well: T. T. Anderson R.R. or street: City, state, zip code: Wilroads Garden, Kansas 67801			
X Locate with "X" in section below: N W E S 1 Mile 1 Mile		Sketch map: 		6. Bore hole dia. 8 in. Completion date 9-28-78 Well depth 140 ft.		
5. Type and color of material		From	To	7. Cable tool <input checked="" type="checkbox"/> Rotary <input type="checkbox"/> Driven <input type="checkbox"/> Dug <input type="checkbox"/> Hollow rod <input type="checkbox"/> Jetted <input type="checkbox"/> Bored <input type="checkbox"/> Reverse rotary		
Top soil & fine to coarse sand		0	15	8. Use: <input checked="" type="checkbox"/> Domestic <input type="checkbox"/> Public supply <input type="checkbox"/> Industry <input type="checkbox"/> Irrigation <input type="checkbox"/> Air conditioning <input type="checkbox"/> Stock <input type="checkbox"/> Lawn <input type="checkbox"/> Oil field water <input type="checkbox"/> Other		
Coarse sand & clay		15	30	9. Casing: Material RMP Height: Above 0 Below Threaded <input type="checkbox"/> Welded <input type="checkbox"/> Surface 12 in. RMP <input checked="" type="checkbox"/> PVC <input type="checkbox"/> Weight <input type="checkbox"/> lbs./ft. Dia. 5 in. to 140 ft. depth Wall Thickness: inches or Dia. <input type="checkbox"/> in. to <input type="checkbox"/> ft. depth Gage No. 250		
Clay & fine sand		30	45	10. Screen: Manufacturer's name Jess & Lowell Type RMP Dia. 5 " Slot/gage 1/8 " Length 20 ft. Set between 115 ft. and 135 ft. ft. and <input type="checkbox"/> ft. Gravel pack? yes Size range of material 1/4 "		
Fine sand		45	60	11. Static water level: <input type="checkbox"/> mo./day/yr. 22 ft. below land surface Date 9-28-78		
Fine sand & clay		60	75	12. Pumping level below land surfaces: 22 ft. after 1 hrs. pumping 75 g.p.m. ft. after <input type="checkbox"/> hrs. pumping <input type="checkbox"/> g.p.m. Estimated maximum yield 100 g.p.m.		
Clay		75	90	13. Water sample submitted: <input type="checkbox"/> Yes <input checked="" type="checkbox"/> No Date <input type="checkbox"/>		
Clay & medium to coarse sand		90	105	14. Well head completion: <input checked="" type="checkbox"/> Pitless adapter 12 inches above grade		
Medium to coarse sand		105	135	15. Well grouted? yes With: <input checked="" type="checkbox"/> Neat cement <input type="checkbox"/> Bentonite <input type="checkbox"/> Concrete Depth: From 5 ft. to 15 ft.		
Clay & blue shale		135	150	16. Nearest source of possible contamination: ft. 60 Direction NE Type Sewer Well disinfected upon completion? <input checked="" type="checkbox"/> Yes <input type="checkbox"/> No		
				17. Pump: <input type="checkbox"/> Not installed Manufacturer's name Goulds Model number 7EH HP 1/2 Volts 115 Length of drop pipe 105 ft. capacity 7 g.p.m. Type: <input checked="" type="checkbox"/> Submersible <input type="checkbox"/> Turbine <input type="checkbox"/> Jet <input type="checkbox"/> Reciprocating <input type="checkbox"/> Centrifugal <input type="checkbox"/> Other		
18. Elevation:		19. Remarks:		20. Water well contractor's certification: This well was drilled under my jurisdiction and this report is true to the best of my knowledge and belief. Joe's Well Service 179 Business name Box 174 Cimarron, Ks. 67833 License No. 174 Address Larry Crick Date 9-28-78 Signed Larry Crick Authorized representative		
Topography: <input type="checkbox"/> Hill <input type="checkbox"/> Slope <input checked="" type="checkbox"/> Upland <input type="checkbox"/> Valley		(Use a second sheet if needed)				

Forward the white, blue and pink copies to the Department of Health and Environment

Form WWC-5