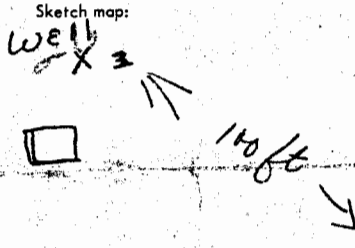


USE TYPEWRITER OR BALL
POINT PEN-PRESS FIRMLY,
PRINT CLEARLY.

WATER WELL RECORD
KSA 82a-1201-1215

Kansas Department of Health and
Environment-Division of Environment
(Water well Contractors)
Topeka, Kansas 66620

X Location of well:		County Ford	Fraction SW 1/4 NE 1/4 NE 1/4	Section number 12	Township number 7	Range number 27	S 24	E/W
2. Distance and direction from nearest town or city: 6 mi East Dodge City			3. Owner of well: Aaron Estabrook R.R. or street: Wilroads Gardens City, state, zip code: Dodge City, Ks 67801					
4. Locate with "X" in section below: N W S E 1 Mile 1 Mile			Sketch map: 		6. Bore hole dia. 8 in. Completion date 5-25-78 Well depth 120 ft.			
5. Type and color of material			From		To		7. <input checked="" type="checkbox"/> Cable tool <input checked="" type="checkbox"/> Rotary <input type="checkbox"/> Driven <input type="checkbox"/> Dug <input type="checkbox"/> Hollow rod <input type="checkbox"/> Jetted <input type="checkbox"/> Bored <input type="checkbox"/> Reverse rotary	
							8. Use: <input checked="" type="checkbox"/> Domestic <input type="checkbox"/> Public supply <input type="checkbox"/> Industry <input type="checkbox"/> Irrigation <input type="checkbox"/> Air conditioning <input type="checkbox"/> Stock <input type="checkbox"/> Lawn <input type="checkbox"/> Oil field water <input type="checkbox"/> Other	
							9. Casing: Material Plastic Height: Above or below Threaded <input type="checkbox"/> Welded <input type="checkbox"/> Surface 120 in. RMP <input type="checkbox"/> PVC <input checked="" type="checkbox"/> 5 in. Weight 250 lbs./ft. Dia. 5 in. to 120 ft. depth Wall Thickness: inches or Dia. 5 in. to 120 ft. depth gauge No. 250	
							10. Screen: Manufacturer's name Jess & Lowell Type Plastic Dia. 5 Slot/gauze 30 Length 30 Set between 90 ft. and 120 ft. ft. and 120 ft. Gravel pack? YES Size range of material +	
							11. Static water level: 20 ft. below land surface Date 5/22/78 mo./day/yr.	
					12. Pumping level below land surfaces: N/A ft. after 0 hrs. pumping 0 g.p.m. ft. after 0 hrs. pumping 0 g.p.m. Estimated maximum yield 0 g.p.m.			
					13. Water sample submitted: 0 mo./day/yr. Yes <input type="checkbox"/> No <input checked="" type="checkbox"/> Date			
					14. Well head completion: <input checked="" type="checkbox"/> Pitless adapter 18 inches above grade			
					15. Well grouted? YES With: <input checked="" type="checkbox"/> Neat cement <input type="checkbox"/> Bentonite <input type="checkbox"/> Concrete Depth: From 0 ft. to 13 ft.			
					16. Nearest source of possible contamination: ft. Direction Type Well disinfected upon completion? <input checked="" type="checkbox"/> Yes <input type="checkbox"/> No			
					17. Pump: <input checked="" type="checkbox"/> Not installed Manufacturer's name Model number HP Volts Length of drop pipe ft. capacity g.p.m. Type: <input type="checkbox"/> Submersible <input type="checkbox"/> Turbine <input type="checkbox"/> Jet <input type="checkbox"/> Reciprocating <input type="checkbox"/> Centrifugal <input type="checkbox"/> Other			
18. Elevation: level			19. Remarks: <div style="text-align: center;">RECEIVED JUN 2 1978 DIVISION OF ENVIRONMENT OF & EG SEC.</div>		20. Water well contractor's certification: This well was drilled under my jurisdiction and this report is true to the best of my knowledge and belief. Crage Well Drilling 111 Business name License No. Address 1308 So Second Dodge City Signed Ray D. Crage Date 5/28/78 Authorized representative			

Forward the white, blue and pink copies to the Department of Health and Environment

Form WWC-5