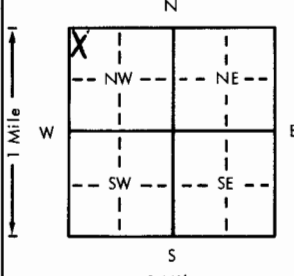
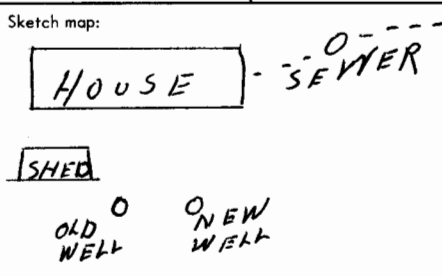


USE TYPEWRITER OR BALL
POINT PEN-PRESS FIRMLY,
PRINT CLEARLY.

WATER WELL RECORD
KSA 82a-1201-1215

Kansas Department of Health and
Environment-Division of Environment
(Water well Contractors)
Topeka, Kansas 66620

Well #1

1. Location of well:	County Ford	Fraction NW 1/4 NW 1/4 NW 1/4	Section number 22	Township number T 27 S R 24 E/W	Range number
2. Distance and direction from nearest town or city: 3 miles south & 4 miles east of Dodge City on highway 283 Street address of well location if in city:			3. Owner of well: W. R. Anderson R.R. or street: 1005 Harris City, state, zip code: Dodge City, Kansas 67801		
4. Locate with "X" in section below: 			Sketch map: 		
5. Type and color of material			From	To	6. Bore hole dia. 8 in. Completion date 2-4-77 Well depth 165 ft.
Top soil & fine sand			0	15	7. <input checked="" type="checkbox"/> Cable tool <input checked="" type="checkbox"/> Rotary <input type="checkbox"/> Driven <input type="checkbox"/> Dug <input type="checkbox"/> Hollow rod <input type="checkbox"/> Jetted <input type="checkbox"/> Bored <input type="checkbox"/> Reverse rotary
Fine sand			15	45	8. Use: <input checked="" type="checkbox"/> Domestic <input type="checkbox"/> Public supply <input type="checkbox"/> Industry <input type="checkbox"/> Irrigation <input type="checkbox"/> Air conditioning <input type="checkbox"/> Stock <input type="checkbox"/> Lawn <input type="checkbox"/> Oil field water <input type="checkbox"/> Other
Fine sand & clay			45	60	9. Casing: Material RMP Height: Above or 100 ft. Threading: <input checked="" type="checkbox"/> Welded <input type="checkbox"/> Surface 12 in. RMP xx PVC <input type="checkbox"/> Weight <input type="checkbox"/> lbs./ft. Dia. 5 in. to 165 ft. depth Wall Thickness: inches or Dia. <input type="checkbox"/> in. to <input type="checkbox"/> ft. depth gage No. 250
Clay & medium to coarse sand			60	75	10. Screen: Manufacturer's name Sunflower Type RMP Dia. 5 " Slot 1/8 " Length 20 ft. Set between 140 ft. and 160 ft. ft. and <input type="checkbox"/> ft.
Medium to coarse sand			75	90	Gravel pack? yes Size range of material 1/2 "
Coarse sand (7ft.) & clay			90	105	11. Static water level: <input type="checkbox"/> mo./day/yr. 65 ft. below land surface Date 2-4-77
Clay & fine sand			105	120	12. Pumping level below land surfaces: 70 ft. after 1 hrs. pumping 50 g.p.m. ft. after <input type="checkbox"/> hrs. pumping <input type="checkbox"/> g.p.m. Estimated maximum yield 65 g.p.m.
Fine sand & coarse sand, clay layers			120	135	13. Water sample submitted: <input type="checkbox"/> Yes <input checked="" type="checkbox"/> No Date <input type="checkbox"/>
Clay (3ft.) & medium sand			135	150	14. Well head completion: <input checked="" type="checkbox"/> Pitless adapter 12 inches above grade
Medium sand & clay rock			150	165	15. Well grouted? yes With: <input checked="" type="checkbox"/> Neat cement <input type="checkbox"/> Bentonite <input type="checkbox"/> Concrete Depth: From 7 ft. to 18 ft.
Rock & blue shale			165	180	16. Nearest source of possible contamination: ft. 70 Direction NE Type Sewer Well disinfected upon completion? <input checked="" type="checkbox"/> Yes <input type="checkbox"/> No
(Use a second sheet if needed)					17. Pump: Manufacturer's name Aermotor Model number SD12-75 HP 3/4 Volts 230 Length of drop pipe 105 ft. capacity 12 g.p.m. Type: <input checked="" type="checkbox"/> Submersible <input type="checkbox"/> Turbine <input type="checkbox"/> Jet <input type="checkbox"/> Reciprocating <input type="checkbox"/> Centrifugal <input type="checkbox"/> Other
18. Elevation:	19. Remarks:		20. Water well contractor's certification: This well was drilled under my jurisdiction and this report is true to the best of my knowledge and belief. Joe's Well Service 179 Business name License No. Address Box 174 Cimarron, Ks. Signed Larry L. Crick Date 3-18-77 Authorized representative		

Forward the white, blue and pink copies to the Department of Health and Environment

Form WWC-5