USE TYPEWRITER OR BALL POINT PEN-PRESS FIRMLY, PRINT CLEARLY.

WATER WELL RECORD
KSA 82a-1201-1215

Kansas Department of Health and Environment-Division of Environment
(Water well Contractors)
Topeka, Kansas 66620

1. Location of well:	County	Fraction	Section number	Township number	Range number
	Ford	SW 1/4 SE 1/4 NE 1/4	13	T 27 S	R 24 E W

2. Distance and direction from nearest town or city: 6 mi. East of Dodge City
Street address of well location if in city:

3. Owner of well: Bob Hodges
R.R. or street: c/o Water Sports Campground
City, state, zip code: DodgeCity, Ks 67801

4. Locate with "X" in section below:

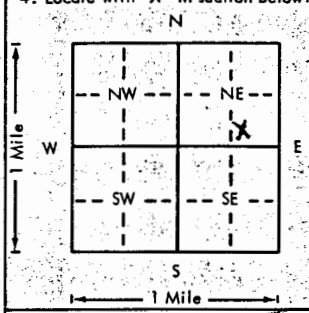

Sketch map:

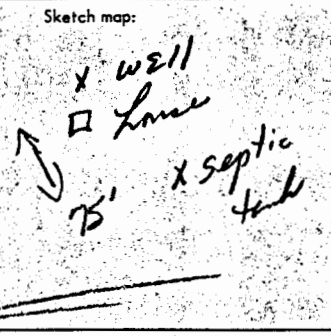

6. Bore hole dia. 8" in. Completion date
Well depth 130 ft. 8-14-79

7. __ Cable tool X Rotary __ Driven __ Dug
__ Hollow rod __ Jetted __ Bored __ Reverse rotary

8. Use: X Domestic __ Public supply __ Industry
__ Irrigation __ Air conditioning __ Stock
__ Lawn __ Oil field water __ Other

9. Casing: Material Plastic Height: Above or Below Surface 18" in.
Threaded ___ Welded Glue Weight 1.280 lbs./ft.
RMP ___ PVC
Dia. 5 in. to 110 ft. depth Wall Thickness: inches or gage No. 250
Dia. ___ in. to ___ ft. depth

10. Screen: Manufacturer's name Jess & Lowell
Type Plastic Dia. 5"
Slot/~~gauze~~ 1/4 Length 20'
Set between 110 ft. and 130 ft.
___ ft. and ___ ft.
Gravel pack? yes Size range of material 1/4

11. Static water level: 40' ft. below land surface Date 8-14-79 (mo./day/yr.)

12. Pumping level below land surfaces: n/a
___ ft. after ___ hrs. pumping ___ g.p.m.
___ ft. after ___ hrs. pumping ___ g.p.m.
Estimated maximum yield ___ g.p.m.

13. Water sample submitted: mo./day/yr.
__ Yes X No Date

14. Well head completion:
X Pitless adapter 15" Inches above grade

15. Well grouted? yes
With: X Neat cement __ Bentonite __ Concrete
Depth: From 0 ft. to 30 ft.

16. Nearest source of possible contamination:
ft. 75 Direction SE Type Septic tank
Well disinfected upon completion? X Yes __ No

17. Pump: __ Not installed
Manufacturer's name Dempster
Model number HF37552 HP 1 Volts 220
Length of drop pipe 105 ft. capacity ___ g.p.m.
Type:
X Submersible __ Turbine
__ Jet __ Reciprocating
__ Centrifugal __ Other

5. Type and color of material	From	To
Topsoil	0	3
Gravel	3	25
Clay	25	100
Gravel	100	130

(Use a second sheet if needed)

RECEIVED
OCT 5 1979
DIVISION OF ENVIRONMENT
OF & EC SEC.

RECEIVED
AUG 31 1979
DIVISION OF ENVIRONMENT
OF & EC SEC.

18. Elevation: Level
Topography:
X Hill
X Slope
X Upland
X Valley

19. Remarks:

20. Water well contractor's certification:
This well was drilled under my jurisdiction and this report is true to the best of my knowledge and belief.
Business name Cragg Well Drilling License No. 111
Address DodgeCity, Ks 67801
Signed [signature] Date 8/30/79
Authorized representative

Forward the white, blue and pink copies to the Department of Health and Environment

Form WWC-5

MI-1023