

County: Ford Fraction: SW SE NW NW Sec. 4 T. 27 S R. 24 W

CORRECTION(S) to WATER WELL COMPLETION RECORD Form WWC-5 (to rectify lacking or incorrect information)

Owner: Cargill Meat Solutions M 2A

If location corrected, was listed as:

Section-Township-Range: 3-27-24W

Fraction (¼ calls): NE SE NW

Location changed to:

4-27-24W

SW SE NW NW

Other changes: Initial statements: Latitude 37.45'59" Longitude 99.57' 28"

Changed to: Lat 37.733055 Long-99.957777 NAD83

Comments: _____

Verification method: Used KGS LEOWEB to convert lat/long and KGS mapper

Initials: SH Date: 03-01-2022

Submitted by: ☒ Kansas Geological Survey, Data Resources Library, 1930 Constant Ave., Lawrence, KS 66047-3724
☐ Kansas Dept. of Health & Environment, Bureau of Water, 1000 SW Jackson, Suite 420, Topeka, KS 66612-1367

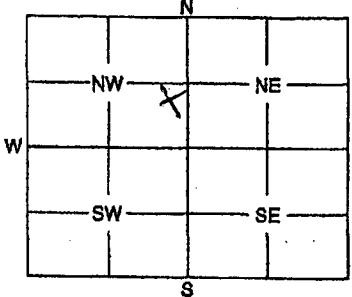
112A

WATER WELL PLUGGING RECORD Form WWC-5P KSA 82a-1212 ID NO. M2A

1	LOCATION OF WATER WELL:	Fraction <u>NE 1/4 SE 1/4 NW 1/4</u>	Section Number <u>3</u>	Township Number <u>27 S</u>	Range Number <u>24</u> <u>EW</u>
County: <u>FORD</u>					

Distance and direction from nearest town or city street address of well if located within city?
1500' SW DODGE RD / HWY 400 34°43'59" 99°57'28"

2	WATER WELL OWNER: <u>CARGILL MEAT SOLUTIONS</u>	Board of Agriculture, Division of Water Resources Application Number:
	RR #, St. Address, Box #: <u>E. HWY 400</u>	
	City, State, ZIP Code: <u>DODGE CITY, KS</u>	

3	MARK WELL'S LOCATION WITH AN "X" IN SECTION BOX: <div style="text-align: center;"></div>	4	DEPTH OF WELL <u>30</u> ft. WELL'S STATIC WATER LEVEL ft. WELL WAS USED AS: <table><tr><td>1 Domestic</td><td>5 Public Water Supply</td><td>9 Dewatering</td></tr><tr><td>2 Irrigation</td><td>6 Oil Field Water Supply</td><td><u>x10 Monitoring Well</u></td></tr><tr><td>3 Feedlot</td><td>7 Domestic (Lawn & Garden)</td><td>11 Injection Well</td></tr><tr><td>4 Industrial</td><td>8 Air Conditioning</td><td>12 Other</td></tr></table> <p>Was a chemical / bacteriological sample submitted to Department? Yes No If yes, mo/day/yr sample was submitted</p> <p>Water Well Disinfected: Yes No</p>	1 Domestic	5 Public Water Supply	9 Dewatering	2 Irrigation	6 Oil Field Water Supply	<u>x10 Monitoring Well</u>	3 Feedlot	7 Domestic (Lawn & Garden)	11 Injection Well	4 Industrial	8 Air Conditioning	12 Other
1 Domestic	5 Public Water Supply	9 Dewatering													
2 Irrigation	6 Oil Field Water Supply	<u>x10 Monitoring Well</u>													
3 Feedlot	7 Domestic (Lawn & Garden)	11 Injection Well													
4 Industrial	8 Air Conditioning	12 Other													

5	TYPE OF BLANK CASING USED: <table><tr><td>1 Steel</td><td>3 RMP (SP)</td><td>5 Wrought</td><td>7 Fiberglass</td><td>9 Other (Specify below)</td></tr><tr><td><u>x 2 PVC</u></td><td>4 ABS</td><td>6 Asbestos-Cement</td><td>8 Concrete Tile</td><td></td></tr></table> <p>Blank casing diameter <u>4</u> in. Was casing pulled? Yes No If yes, how much Casing height above or below land surface <u>0</u> in.</p>	1 Steel	3 RMP (SP)	5 Wrought	7 Fiberglass	9 Other (Specify below)	<u>x 2 PVC</u>	4 ABS	6 Asbestos-Cement	8 Concrete Tile	
1 Steel	3 RMP (SP)	5 Wrought	7 Fiberglass	9 Other (Specify below)							
<u>x 2 PVC</u>	4 ABS	6 Asbestos-Cement	8 Concrete Tile								

6	GROUT PLUG MATERIAL: 1 Neat cement 2 Cement grout 3 Bentonite 4 Other <u>BENTONITE GROUT</u> Grout Plug Intervals: From <u>30</u> ft. to <u>0</u> ft., From ft. to ft., From ft. to ft. What is the nearest source of possible contamination: <table><tr><td>1 Septic tank</td><td>6 Seepage pit</td><td>11 Fuel storage</td><td>16 Other (specify below)</td></tr><tr><td>2 Sewer lines</td><td>7 Pit privy</td><td>12 Fertilizer storage</td><td></td></tr><tr><td>3 Watertight sewer lines</td><td>8 Sewage lagoon</td><td>13 Insecticide storage</td><td></td></tr><tr><td>4 Lateral lines</td><td>9 Feedyard</td><td>14 Abandoned water well</td><td></td></tr><tr><td>5 Cess pool</td><td>10 Livestock pens</td><td>15 Oil well/Gas well</td><td></td></tr></table> <p>Direction from well? How many feet?</p>	1 Septic tank	6 Seepage pit	11 Fuel storage	16 Other (specify below)	2 Sewer lines	7 Pit privy	12 Fertilizer storage		3 Watertight sewer lines	8 Sewage lagoon	13 Insecticide storage		4 Lateral lines	9 Feedyard	14 Abandoned water well		5 Cess pool	10 Livestock pens	15 Oil well/Gas well	
1 Septic tank	6 Seepage pit	11 Fuel storage	16 Other (specify below)																		
2 Sewer lines	7 Pit privy	12 Fertilizer storage																			
3 Watertight sewer lines	8 Sewage lagoon	13 Insecticide storage																			
4 Lateral lines	9 Feedyard	14 Abandoned water well																			
5 Cess pool	10 Livestock pens	15 Oil well/Gas well																			

FROM	TO	PLUGGING MATERIALS
30	0	BENTONITE GROUT

7	CONTRACTOR'S OF LANDOWNER'S CERTIFICATION: This water well was plugged under my jurisdiction and was completed on (mo/day/year) <u>8/24/10</u> and this record is true to the best of my knowledge and belief. Kansas Water Well Contractor's License No. <u>102</u> This Water Well Record was completed on (mo/day/year) <u>8/24/10</u> under the business name of <u>LAYNE CHRISTENSEN COMPANY</u> by (signature) <u>[Signature]</u>
---	---

INSTRUCTIONS: Use typewriter or ball point pen. Please press firmly and print clearly. Please fill in blanks, underline or circle the correct answers. Send top three copies to Kansas Department of Health and Environment, Bureau of Water, Geology Section, 1000 SW Jackson St., Ste. 420, Topeka, Kansas 66612-1367. Telephone: 785/296-5522. Send one to Water Well Owner and retain one for your records.