

County: Ford Fraction: NE SE NW NW Sec. 4 T. 27 S R. 24 W

CORRECTION(S) to WATER WELL COMPLETION RECORD Form WWC-5 (to rectify lacking or incorrect information)

Owner: Cargill Meat Solutions

M 9A

If location corrected, was listed as:

Location changed to:

Section-Township-Range: 3-27-24W

4-27-24W

Fraction (1/4 calls): NE SE NW

NE SE NW NW

Other changes: Initial statements: Latitude 37.44'02" Longitude 99.57' 25"

Changed to: Lat 37.733866 Long-99.956944 NAD83

Comments: _____

Verification method: Used KGS LEOWEB to convert lat/long, KGS mapper speaking with Pam Chaffee and email from Cargill.

Initials: SH Date: 03-01-2022

Submitted by: ☒ Kansas Geological Survey, Data Resources Library, 1930 Constant Ave., Lawrence, KS 66047-3724
☐ Kansas Dept. of Health & Environment, Bureau of Water, 1000 SW Jackson, Suite 420, Topeka, KS 66612-1367

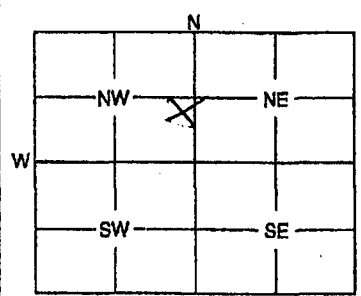
m9A

WATER WELL PLUGGING RECORD Form WWC-5P KSA 82a-1212 ID NO. M9A

1	LOCATION OF WATER WELL:	Fraction	Section Number	Township Number	Range Number
	County: FORD	NE 1/4 SE 1/4 NW 1/4	3	27 S	24 E/W

Distance and direction from nearest town or city street address of well if located within city?
1500' SW OF DODGE RD / HWY 400 37'44'02" 99°57'25"

2	WATER WELL OWNER: CARGILL MEAT SOLUTIONS	Board of Agriculture, Division of Water Resources
	RR #, St. Address, Box #: E. HWY 400	Application Number:
	City, State, ZIP Code: DODGE CITY, KS	

3	MARK WELL'S LOCATION WITH AN "X" IN SECTION BOX:	4	DEPTH OF WELL 30 ft.
			WELL'S STATIC WATER LEVEL ft.
			WELL WAS USED AS:
			1 Domestic 5 Public Water Supply 9 Dewatering
			2 Irrigation 6 Oil Field Water Supply x10 Monitoring Well
			3 Feedlot 7 Domestic (Lawn & Garden) 11 Injection Well
			4 Industrial 8 Air Conditioning 12 Other
			Was a chemical / bacteriological sample submitted to Department? Yes No
			If yes, mo/day/yr sample was submitted
			Water Well Disinfected: Yes No

5	TYPE OF BLANK CASING USED:
	1 Steel 3 RMP (SR) 5 Wrought 7 Fiberglass 9 Other (Specify below)
	x 2 PVC 4 ABS 6 Asbestos-Cement 8 Concrete Tile
	Blank casing diameter 4 in. Was casing pulled? Yes No If yes, how much
	Casing height above or below land surface 0 in.

6	GROUT PLUG MATERIAL: 1 Neat cement 2 Cement grout 3 Bentonite 4 Other BENTONITE GROUT
	Grout Plug Intervals: From 30 ft. to 0 ft., From ft. to ft., From ft. to ft.
	What is the nearest source of possible contamination:
	1 Septic tank 6 Seepage pit 11 Fuel storage 16 Other (specify below)
	2 Sewer lines 7 Pit privy 12 Fertilizer storage
	3 Watertight sewer lines 8 Sewage lagoon 13 Insecticide storage
	4 Lateral lines 9 Feedyard 14 Abandoned water well
	5 Cess pool 10 Livestock pens 15 Oil well/Gas well
	Direction from well? How many feet?

FROM	TO	PLUGGING MATERIALS
30	0	BENTONITE GROUT

7	CONTRACTOR'S OF LANDOWNER'S CERTIFICATION: This water well was plugged under my jurisdiction and was completed on (mo/day/year) 8/25/10 and this record is true to the best of my knowledge and belief, Kansas Water Well Contractor's License No. 10 This Water Well Record was completed on (mo/day/year) 12/18/10 under the business name of LAYNE CHRISTENSEN COMPANY by (signature) [Signature]
---	--

INSTRUCTIONS: Use typewriter or ball point pen. Please press firmly and print clearly. Please fill in blanks, underline or circle the correct answers. Send top three copies to Kansas Department of Health and Environment, Bureau of Water, Geology Section, 1000 SW Jackson St., Ste. 420, Topeka, Kansas 66612-1367. Telephone: 785/296-5522. Send one to Water Well Owner and retain one for your records.