

## ASSIGNMENT OF WATER WELL TO LANDOWNER

Ford County  
% Ed Elam  
100 Gunsmoke St.  
Dodge City, KS 67801,

is the landowner on which a water well is located approximately

2700' FSL & 4600' FEL  
Section 12-27S-24W  
Ford County, Kansas.

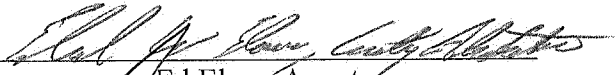
Said water well was drilled on or about December 30, 2012  
under Temporary Permit File No. 20120956.

As landowners, we hereby request that Ritchie Exploration, Inc. (operator) leave the water well unplugged, and we agree to properly maintain said well, and upon abandonment of said well, we will assume all responsibility for the plugging of said water well in accordance with the requirements of the Kansas Department of Health and Environment regulations K.A.R. 28-30-7. As consideration for the transfer of this well, we will allow operator to have free use of said well if the situation should arise in the future whereby the operator has additional drilling in the area.

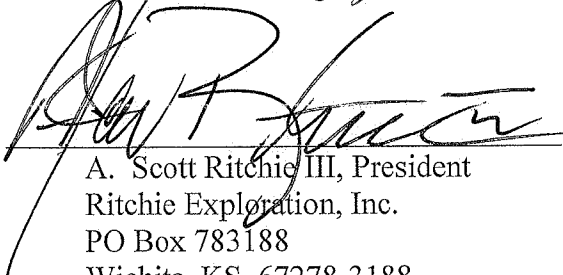
This transfer to be effective March 31, 2013.

**Ford County**

LANDOWNER:

  
Ed Elam, Agent

OPERATOR:

  
A. Scott Ritchie III, President  
Ritchie Exploration, Inc.  
PO Box 783188  
Wichita, KS 67278-3188  
(316) 691-9500

TO: Kansas Dept. of Health & Environment  
Bureau of Water – Geology Section  
1000 S.W. Jackson, Suite #420  
Topeka, KS 66612-1367

Kansas Dept. of Agriculture  
Division of Water Resources  
109 SW 9<sup>th</sup> Street, 2<sup>nd</sup> Floor  
Topeka, KS 66612-1283

RECEIVED

MAR 25 2013

BUREAU OF WATER

## WATER WELL RECORD

## Form WWC-5

Division of Water Resources App. No.

20120956

<b>1 LOCATION OF WATER WELL:</b> County: Ford		Fraction 1/4 SE 1/4 SW 1/4 NW 1/4	Section Number 12	Township No. T 27 S	Range Number R 24 <input type="checkbox"/> E <input checked="" type="checkbox"/> W
Street/Rural Address of Well Location; if unknown, distance & direction from nearest town or intersection: If at owner's address, check here <input type="checkbox"/> 1 North, 1/4 West of Wilroads			<b>Global Positioning System (GPS) information:</b> Latitude: ..... (in decimal degrees) Longitude: ..... (in decimal degrees) Elevation: ..... Datum: <input type="checkbox"/> WGS 84, <input type="checkbox"/> NAD 83, <input type="checkbox"/> NAD 27 Collection Method: <input type="checkbox"/> GPS unit (Make/Model: .....) <input type="checkbox"/> Digital Map/Photo, <input type="checkbox"/> Topographic Map, <input type="checkbox"/> Land Survey Est. Accuracy: <input type="checkbox"/> <3 m, <input type="checkbox"/> 3-5 m, <input type="checkbox"/> 5-15 m, <input type="checkbox"/> >15 m		
<b>2 WATER WELL OWNER:</b> Ritchie Exploration RR#, Street Address, Box #: P.O. Box 782188 City, State, ZIP Code : Wichita, KS 67278					
<b>3 LOCATE WELL WITH AN "X" IN SECTION BOX:</b> N <div style="border: 1px solid black; width: 100px; height: 100px; position: relative; margin: 10px auto;"> <div style="position: absolute; top: 0; left: 0; width: 100%; height: 100%; border: 1px solid black; border-style: dashed;"> <div style="position: absolute; top: 0; left: 0; width: 50%; height: 50%; border: 1px solid black;">NW</div> <div style="position: absolute; top: 0; right: 0; width: 50%; height: 50%; border: 1px solid black;">NE</div> <div style="position: absolute; bottom: 0; left: 0; width: 50%; height: 50%; border: 1px solid black;">SW</div> <div style="position: absolute; bottom: 0; right: 0; width: 50%; height: 50%; border: 1px solid black;">SE</div> </div> <div style="position: absolute; top: 50%; left: 50%; transform: translate(-50%, -50%); font-size: 2em;">X</div> </div> <div style="text-align: center; margin-top: 5px;">S -----1 mile-----</div>		<b>4 DEPTH OF COMPLETED WELL</b> 115 ..... ft. Depth(s) Groundwater Encountered (1) ..... ft. (2) ..... ft. (3) ..... ft. WELL'S STATIC WATER LEVEL 26 ..... ft. below land surface measured on mo/day/yr. 12-30-12 ..... Pump test data: Well water was ..... ft. after ..... hours pumping ..... gpm EST. YIELD. N/A ..... gpm. Well water was ..... ft. after ..... hours pumping ..... gpm Bore Hole Diameter 10 ..... in. to 115 ..... ft., and ..... in. to ..... ft. WELL WATER TO BE USED AS: <input type="checkbox"/> Public water supply <input type="checkbox"/> Geothermal <input type="checkbox"/> Injection well <input type="checkbox"/> Domestic <input type="checkbox"/> Feedlot <input checked="" type="checkbox"/> Oil field water supply <input type="checkbox"/> Dewatering <input type="checkbox"/> Other (Specify below) <input type="checkbox"/> Irrigation <input type="checkbox"/> Industrial <input type="checkbox"/> Domestic-lawn & garden <input type="checkbox"/> Monitoring well ..... Was a chemical/bacteriological sample submitted to Department? <input type="checkbox"/> Yes <input checked="" type="checkbox"/> No If yes, mo/day/yr sample was submitted. .... Water well disinfected? <input checked="" type="checkbox"/> Yes <input type="checkbox"/> No			
<b>5 TYPE OF CASING USED:</b> <input type="checkbox"/> Steel <input checked="" type="checkbox"/> PVC <input type="checkbox"/> Other ..... CASING JOINTS: <input checked="" type="checkbox"/> Glued <input type="checkbox"/> Clamped <input type="checkbox"/> Welded <input type="checkbox"/> Threaded Casing diameter 5 ..... in. to 115 ..... ft., Diameter ..... in. to ..... ft., Diameter ..... in. to ..... ft. Casing height above land surface 18 ..... in., Weight SDR-26 ..... lbs./ft., Wall thickness or gauge No. .... TYPE OF SCREEN OR PERFORATION MATERIAL: <input type="checkbox"/> Steel <input type="checkbox"/> Stainless Steel <input checked="" type="checkbox"/> PVC <input type="checkbox"/> Other (Specify) ..... <input type="checkbox"/> Brass <input type="checkbox"/> Galvanized Steel <input type="checkbox"/> None used (open hole) SCREEN OR PERFORATION OPENINGS ARE: <input type="checkbox"/> Continuous slot <input type="checkbox"/> Mill slot <input type="checkbox"/> Gauze wrapped <input type="checkbox"/> Torch cut <input type="checkbox"/> Drilled holes <input type="checkbox"/> None (open hole) <input type="checkbox"/> Louvered shutter <input type="checkbox"/> Key punched <input type="checkbox"/> Wire wrapped <input checked="" type="checkbox"/> Saw cut <input type="checkbox"/> Other (specify) ..... SCREEN-PERFORATED INTERVALS: From 115 ..... ft. to 55 ..... ft., From ..... ft. to ..... ft. From ..... ft. to ..... ft., From ..... ft. to ..... ft. GRAVEL PACK INTERVALS: From 115 ..... ft. to 20 ..... ft., From ..... ft. to ..... ft. From ..... ft. to ..... ft., From ..... ft. to ..... ft.					
<b>6 GROUT MATERIAL:</b> <input type="checkbox"/> Neat cement <input type="checkbox"/> Cement grout <input checked="" type="checkbox"/> Bentonite <input type="checkbox"/> Other ..... Grout Intervals: From ..... ft. to ..... ft., From 20 ..... ft. to 0 ..... ft., From ..... ft. to ..... ft. What is the nearest source of possible contamination: <input type="checkbox"/> Septic tank <input type="checkbox"/> Lateral lines <input type="checkbox"/> Pit privy <input type="checkbox"/> Livestock pens <input type="checkbox"/> Insecticide storage <input checked="" type="checkbox"/> Other (specify below) <input type="checkbox"/> Sewer lines <input type="checkbox"/> Cesspool <input type="checkbox"/> Sewage lagoon <input type="checkbox"/> Fuel storage <input type="checkbox"/> Abandoned water well <input type="checkbox"/> Watertight sewer lines <input type="checkbox"/> Seepage pit <input type="checkbox"/> Feedyard <input type="checkbox"/> Fertilizer storage <input type="checkbox"/> Oil well/gas well River ..... Direction from well South ..... Distance from well 300ft .....					
FROM	TO	LITHOLOGIC LOG	FROM	TO	LITHO. LOG (cont.) or PLUGGING INTERVALS
0	7	Top soil & clay			
7	15	Sand & gravel- coarse			
15	46	Tan clay w/ gravel streaks			
46	80	Sand & gravel- w/ clay streaks			
80	107	Sand & gravel- small w/ rock			
107	112	Yellow clay & limestone			
112	115	Black shale			
<b>7 CONTRACTOR'S OR LANDOWNER'S CERTIFICATION:</b> This water well was <input checked="" type="checkbox"/> constructed, <input type="checkbox"/> reconstructed, or <input type="checkbox"/> plugged under my jurisdiction and was completed on (mo/day/year) 12-30-12 ..... and this record is true to the best of my knowledge and belief. Kansas Water Well Contractor's License No. 134 ..... This Water Well Record was completed on (mo/day/year) 2-13-13 ..... under the business name of Rosencrantz- Bemis ..... by (signature) <i>Rosencrantz- Bemis</i> .....					
<b>INSTRUCTIONS:</b> Use typewriter or ball point pen. PLEASE PRESS FIRMLY and PRINT clearly. Please fill in blanks and check the correct answers. Send three copies (white, blue, pink) to Kansas Department of Health and Environment, Bureau of Water, Geology Section, 1000 SW Jackson St., Suite 420, Topeka, Kansas 66612-1367. Telephone 785-296-5524. Send one copy to WATER WELL OWNER and retain one for your records. Include fee of \$5.00 for each constructed well. Visit us at <a href="http://www.kdheks.gov/waterwell/index.html">http://www.kdheks.gov/waterwell/index.html</a> .					