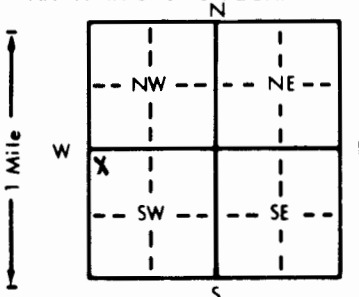


1 LOCATION OF WATER WELL:		Fraction		Section Number		Township Number		Range Number			
County: FORD		NW 1/4 NW 1/4 SW 1/4		4		T 27 S		R 24 E/W			
Distance and direction from nearest town or city street address of well if located within city? HWY 154, 2 MILES SOUTHWEST OF DODGE CITY											
2 WATER WELL OWNER:		WEST PLAINS ENERGY									
RR#, St. Address, Box # :		PO BOX 1180									
City, State, ZIP Code :		DODGE CITY KANSAS 67801									
Board of Agriculture, Division of Water Resources Application Number:											
3 LOCATE WELL'S LOCATION WITH AN "X" IN SECTION BOX:		4 DEPTH OF COMPLETED WELL: 158 ft. ELEVATION:									
		Depth(s) Groundwater Encountered 1. 13 ft. 2. ft. 3. ft.									
		WELL'S STATIC WATER LEVEL UNKNOWN ft. below land surface measured on mo/day/yr									
		Pump test data: Well water was ft. after hours pumping gpm									
		Est. Yield gpm: Well water was ft. after hours pumping gpm									
		Bore Hole Diameter .8 in. to 158 ft. and in. to ft.									
WELL WATER TO BE USED AS:											
1 Domestic 3 Feedlot 6 Oil field water supply 9 Dewatering 12 Other (Specify below)											
2 Irrigation 4 Industrial 7 Lawn and garden only 10 Monitoring well											
Was a chemical/bacteriological sample submitted to Department? Yes No; If yes, mo/day/yr sample was submitted											
Water Well Disinfected? Yes No											
5 TYPE OF BLANK CASING USED:											
1 Steel 3 RMP (SR) 5 Wrought iron 8 Concrete tile CASING JOINTS: Glued Clamped											
2 PVC 4 ABS 6 Asbestos-Cement 9 Other (specify below) Welded											
Blank casing diameter 4.5 in. to 130 ft. Dia in. to ft. Dia in. to ft.											
Casing height above land surface 0 in., weight 2.07 lbs./ft. Wall thickness or gauge No. 0.337											
TYPE OF SCREEN OR PERFORATION MATERIAL:											
1 Steel 3 Stainless steel 5 Fiberglass 7 PVC 10 Asbestos-cement											
2 Brass 4 Galvanized steel 6 Concrete tile 9 ABS 11 Other (specify)											
SCREEN OR PERFORATION OPENINGS ARE: 0.020											
1 Continuous slot 3 Mill slot 5 Gauzed wrapped 8 Saw cut 11 None (open hole)											
2 Louvered shutter 4 Key punched 6 Wire wrapped 9 Drilled holes											
7 Torch cut 10 Other (specify)											
SCREEN-PERFORATED INTERVALS: From 130 ft. to 145 ft. From ft. to ft.											
GRAVEL PACK INTERVALS: From 126 ft. to 145 ft. From ft. to ft.											
6 GROUT MATERIAL:											
1 Neat cement 2 Cement grout 3 Bentonite 4 Other											
Grout Intervals: From SURFACE ft. to 124 ft. From 124 ft. to 126 ft. From ft. to ft.											
What is the nearest source of possible contamination:											
1 Septic tank 4 Lateral lines 7 Pit privy 10 Livestock pens 14 Abandoned water well											
2 Sewer lines 5 Cess pool 8 Sewage lagoon 11 Fuel storage 15 Oil well/Gas well											
3 Watertight sewer lines 6 Seepage pit 9 Feedyard 12 Fertilizer storage 16 Other (specify below)											
13 Insecticide storage UNKNOWN											
Direction from well? How many feet?											
FROM		TO		LITHOLOGIC LOG		FROM		TO		PLUGGING INTERVALS	
0		3		SAND-TAN, FG, POORLY SORTED, SOME GRAVEL W/FELDSPAR		53		58		SAND-BRN MED GR, SUBANG MIXED W/COARSE GR SD/GRAVEL	
3		8		SAND/GRAVEL-FINE GRAVEL, COARSE GR SAND, TAN ANG-SUB ANG, MOD SORTED GTZ & RED & PINK FELDSPAR		58		63		SAND-TAN VFG SUBRND TO RND	
						63		68		SAND-TAN FG TO MED GR, SUB RND.	
						68		73		SAA	
8		13		SAA		73		78		SAND/GRAVEL-COARSE SOL & GRAVEL	
13		15		SAA		78		103		SAND-COARSE AR TAN, MOD SORTING	
18		23		CLAY WHITE, SLI PLASTIC		103		108		SAND/GRAVEL YCG SOL W/GRAVEL	
23		28		CLAY SAA W/COARSE GRAVEL		108		133		SAND-TAN, MED GRAIN SUB, RND, SORTED	
28		33		CLAY INTERBEDDED WHITE CL & GRAVEL		133		138		SAND/GRAVEL COARSE SAND	
33		38		SAND-TAN, VFG, ANG TO SUB ANG		138		153		SAND TAN TO LT BRN SUB RND SORTED	
38		43		SAND-TAN, FG, SUBANG, WELL SORTED		153		155		SHALE, DK GREY GRADING TO TAN LS	
43		48		SAND - SAA		155		158		LIMESTONE-FAN LS (PROBABLY)	
48		53		SAND-TAN, VFG, WELL SORTED, MIXED W/MG SAND						(GREENHORN LS)	
7 CONTRACTOR'S OR LANDOWNER'S CERTIFICATION: This water well was (1) constructed, (2) reconstructed, or (3) plugged under my jurisdiction and was completed on (mo/day/year) 9/13/94 and this record is true to the best of my knowledge and belief. Kansas Water Well Contractor's License No. 438 This Water Well Record was completed on (mo/day/yr) 9/29/94 under the business name of KANSAS CITY TESTING LAB by (signature) William J. Purdon											
INSTRUCTIONS: Use typewriter or ball point pen. PLEASE PRESS FIRMLY and PRINT clearly. Please fill in blanks, underline or circle the correct answers. Send up three copies to Kansas Department of Health and Environment, Bureau of Water, Topeka, Kansas 66620-0001. Telephone: 913-296-5545. Send one to WATER WELL OWNER and retain one for your records.											

9122819016