


1 LOCATION OF WATER WELL: Fraction Section Number Township Number Range Number
 COUNTY: FORD SW 1/4 NE 1/4 SW 1/4 36 T 28 27 S R 25 W

Distance and direction from nearest town or city street address of well if located within city?
 DODGE CITY S. ON HIGHWAY 283 TO RICHLAND VALLEY SCHOOL 1/4 East

2 WATER WELL OWNER: HOOPER, LLOYD
 RR#, St. Address, Box #: 1509 MULBERRY CIRCLE
 City, State, ZIP code: DODGE CITY, KS 67801- Board of Agriculture, Division of Water Resources
 Application Number:

3 LOCATE WELL'S LOCATION WITH AN "X" IN SECTION BOX:

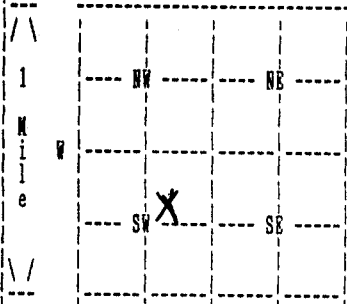

4 DEPTH OF COMPLETED WELL 225 ELEVATION: 0
 Depth(s) Groundwater Encountered 1. 0 ft. 2. 0 ft. 3. 0 ft.

WELL'S STATIC WATER LEVEL 138 ft. below land surface measured on no/day/yr 09/26/95
 Pump test data: Well water was 0 ft. after 0 hours pumping 0 gpm

Estimated Yield 40 gpm: Well water was 0 ft. after 0 hours pumping 0 gpm

Bore Hole Diameter 10 in. to 225 ft., and in. to 0 ft.

WELL WATER TO BE USED AS: DOMESTIC

Was a chemical/bacteriological sample submitted to department? No;
 If yes, no/day/yr sample was submitted Water well disinfected? Yes

5 TYPE OF BLANK CASING USED: PVC CASING JOINTS: GLUED
 Blank casing diameter 5 in. to 225 ft., Dia in. to 0 ft., Dia in. to 0 ft.
 Casing height above land surface 12 in., weight 200 lbs/ft. Wall thickness or gauge No. 21
 TYPE OF SCREEN OR PERFORATION MATERIAL: PVC
 SCREEN OR PERFORATION OPENINGS ARE: SAW CUT

SCREEN PERFORATED INTERVALS: From 180 ft. to 220 ft., From 0 ft. to 0 ft.
 GRAVEL PACK INTERVALS: From 0 ft. to 0 ft., From 0 ft. to 0 ft.
 From 40 ft. to 225 ft., From 0 ft. to 0 ft.
 From 0 ft. to 0 ft., From 0 ft. to 0 ft.

6 GROUT MATERIAL BENTONITE
 Grout intervals: From 0 ft. to 40 ft., From 0 ft. to 0 ft., From 0 ft. to 0 ft.
 What is the nearest source of possible contamination: NONE - NEW SITE
 Direction from well? How many feet? 0

| FROM | TO | LITHOLOGIC LOG |
|------|-----|------------------------------------|
| 0 | 60 | TOPSOIL CLAY FINE SAND |
| 60 | 100 | FINE SAND |
| 100 | 120 | FINE - MED SAND VERY LOOSE |
| 120 | 140 | FINE - MED SAND COARSE SAND GRAVEL |
| 140 | 160 | CLAY FINE SAND IN LAYERS |
| 160 | 180 | CLAY FINE - MED SAND IN LAYERS |
| 180 | 200 | FINE - MED SAND |
| 200 | 218 | FINE - MED SAND SMALL GRAVEL |
| 218 | 240 | CLAY THIN ROCK LAYER BLUE SHALE |

| FROM | TO | PLUGGING INTERVALS |
|------|----|--------------------|
| | | |

7 CONTRACTOR'S OR LANDOWNER'S CERTIFICATION: This water well was Constructed under my jurisdiction and was completed on (no/day/year) 09/28/95 and this record is true to the best of my knowledge and belief. Kansas Water Well Contractor's License No. 179 This Water Well Record was completed on (no/day/yr) 10/24/95 under the business name of JOE'S WELL SERVICE, INC. by (signature) *Joe's Well Service*