

USE TYPEWRITER OR BALL POINT PEN—PRESS FIRMLY, PRINT CLEARLY.

T R EW sec 1/4 1/4 1/4 No.

WATER WELL RECORD
KSA 82a-1201-1215

Kansas State Dept. Of Health
(Water Well Contractors)
Forbes-Bldg. 740
Topeka, Kansas 66620


1 Location of well:	County Ford	Township name Richland	Fraction SE 1/4	Section number 1	Town number T-27	Range number R-25-W
---------------------	-----------------------	----------------------------------	---------------------------	----------------------------	----------------------------	-------------------------------

Distance and direction from nearest town or city:
1/4 mi south of Dodge City, Kansas

Street address of well location if in city:

3 Owner of well: **Dean Shelor**
Bloom, Kansas

Address:

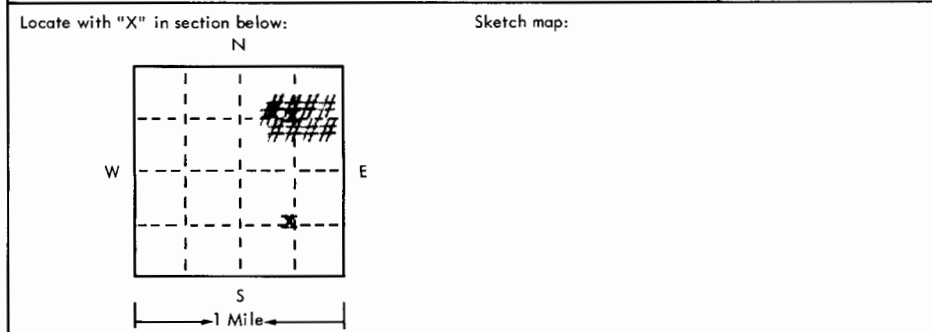

4 Well depth: **176** ft. Date of completion **12-30-74**
Well diameter _____ in.

5 Cable tool Rotary Driven Dug
 Hollow rod Jetted Bored Reverse rotary

6 Use: Domestic Public supply Industry
 Irrigation Air conditioning Commercial
 Test well

7 Casing: Material _____ Height: above/below
Threaded Welded Surface _____ in.
Diam. _____ Weight _____ lbs./ft. _____
_____ in. to _____ ft. depth! Drive shoe? Yes No
_____ in. to _____ ft. depth!

2	Type and color of material	From	To

8 Screen:
Manufacturer _____
Type _____ Dia. _____
Slot/gauze _____ Length _____
Set between _____ ft. and _____ ft. _____
Fittings:
Gravel pack Yes No Size range of material _____

9 Static water level:
_____ ft. below land surface Date _____

10 Pumping level below land surfaces:
_____ ft. after _____ hrs. pumping _____ g.p.m.
_____ ft. after _____ hrs. pumping _____ g.p.m.
Estimated maximum yield _____ g.p.m.

11 Water sample submitted:
 Yes No Date _____

12 Well head completion:
 Pitless adapter Inches above grade

13 Well grouted? Yes No
 Neat cement Bentonite _____
Depth: From _____ ft. to _____ ft.

14 Nearest source of possible contamination:
ft. _____ Direction _____ Type _____
Well disinfected upon completion? Yes No

15 Pump: Not installed
Manufacturer's name **Goulds** **3-19-75**
Model number **12JMO** HP **75** Volts **460**
Length of drop pipe **160** ft. capacity **800** g.m.p.
Type:
 Submersible Turbine
 Jet Reciprocating
 Centrifugal Other

16 Remarks: elevation

(use a second sheet if needed)

Topography:
 Hill
 Slope
 Upland
 Valley

17 Water well contractor's certification:
This well was drilled under my jurisdiction and this report is true to the best of my knowledge and belief.
Ace-Hi Drilling Co **190**
Business name License No.
Address **Box 1442, Dodge City, Ks**
Signed **Cal C Tuttle** Date **3-26-75**
Authorized representative