

1 LOCATION OF WATER WELL:		Fraction	Section Number	Township Number	Range Number
County:	Ford	SE ¼ SW ¼ SW ¼	2	T 27 S	R 25 E/W


1 LOCATION OF WATER WELL:		Fraction	Section Number	Township Number	Range Number
County:	Ford	SE ¼ SW ¼ SW ¼	2	T 27 S	R 25 E/W

Distance and direction from nearest town or city street address of well if located within city?

From junction 283 & 56 highway - 3/4 mile West

2	WATER WELL OWNER:	Midwest Salvage Inc.	
	RR#, St. Address, Box # :	% Maupin Truck Parts - 1000 Minneola Road	Board of Agriculture, Division of Water Resources
	City, State, ZIP Code :	Dodge City, Kansas 67801	Application Number:

3 LOCATE WELL'S LOCATION WITH AN "X" IN SECTION BOX: 4 DEPTH OF COMPLETED WELL... 177... ft. ELEVATION: .....

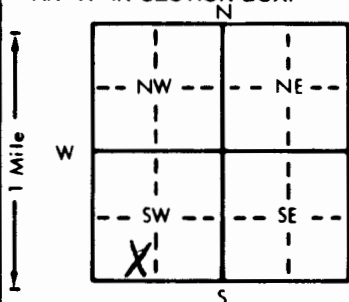

Depth(s) Groundwater Encountered 1. . . . . ft. 2. . . . . ft. 3. . . . . ft.  
WELL'S STATIC WATER LEVEL 45. . . . . ft. below land surface measured on mo/day/yr 9-23-91

	Pump test data:	Well water was	ft. after	hours pumping	gpm
Est. Yield	50 gpm:	Well water was	ft. after	hours pumping	gpm

Bore Hole Diameter. 10 in. to 177 ft., and        in. to        ft.

WELL WATER TO BE USED AS:      5 Public water supply      8 Air conditioning      11 Injection well

1 Domestic	3 Feedlot	6 Oil field water supply	9 Dewatering	12 Other (Specify below)
2 Irrigation	4 Industrial	7 Lawn and garden only	10 Monitoring well	

Was a chemical/bacteriological sample submitted to Department? Yes.....No. XX.....; If yes, mo/day/yr sample was submitted  
Water Well Disinfected? Yes XX No

5	TYPE OF BLANK CASING USED:		5 Wrought iron	8 Concrete tile	CASING JOINTS: Glued <u>XX</u> . . . . . Clamped . . . . . Welded . . . . .
	1 Steel	3 RMP (SR)	6 Asbestos-Cement	9 Other (specify below)	

Blank casing diameter 5 in. to 177 ft. Dia

Casing height above land surface . . . . . 12 . . . . . in., weight . . . . . 200 . . . . . lbs./ft. Wall thickness or gauge No. . . . . SDR 21 . . . . .

TYPE OF SCREEN OR PERFORATION MATERIAL : . . . . . 7 PVC . . . . . 10 Asbestos-cement

1 Steel	3 Stainless steel	5 Fiberglass	7 RMP (SR)	9 Absorbent cement
2 Brass	4 Galvanized steel	6 Concrete tile	8 RMP (SR)	10 Other (specify) .....
			9 ABS	11 None used (open hole)

SCREEN OR PERFORATION OPENINGS ARE:

1 Continuous slot	3 Mill slot	6 Wire wrapped	9 Drilled holes
2 Louvered shutter	4 Key punched	7 Torch cut	10 Other (specify) .....
SCREEN REPERFORATED INTERVALS:	From 152	To 172	# From # To #

SCREEN-PERFORATED INTERVALS:			From . . . . . ft. to . . . . . ft.			From . . . . . ft. to . . . . . ft.		
GRAVEL BACK INTERVALS:			From . . . . . ft. to . . . . . ft.			From . . . . . ft. to . . . . . ft.		

[illegible]

7 CONTRACTOR'S OR LANDOWNER'S CERTIFICATION: This water well was (1) constructed, (2) reconstructed, or (3) plugged under my jurisdiction and was completed on (mo/day/year) 9-24-91 and this record is true to the best of my knowledge and belief. Kansas Water Well Contractor's License No. 179 This Water Well Record was completed on (mo/day/yr) 10-18-91 under the business name of Joe's Well Service, Inc. Cimarron, Kansas by (signature) Joe's Well Service