


1 LOCATION OF WATER WELL: County: <u>Ford</u>	Fraction <u>NW 1/4 NW 1/4 NE 1/4</u>	Section Number <u>3</u>	Township Number <u>T 27 S</u>	Range Number <u>R 25 E</u>
--	---	----------------------------	----------------------------------	-------------------------------

Distance and direction from nearest town or city street address of well if located within city?

1800 McArthur Rd. Lot G. Lewis Addition

2 WATER WELL OWNER: <u>Ed Stith</u> RR#, St. Address, Box # : <u>1800 McArthur Rd.</u> City, State, ZIP Code : <u>Dodge City, KS. 67801</u>	Board of Agriculture, Division of Water Resources Application Number:
---	--

3 LOCATE WELL'S LOCATION WITH AN "X" IN SECTION BOX:	4 DEPTH OF COMPLETED WELL: <u>180'</u> ft. ELEVATION:
--	---

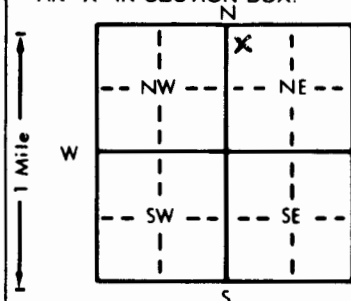

Depth(s) Groundwater Encountered 1. ft. 2. ft. 3. ft.

WELL'S STATIC WATER LEVEL 54' ft. below land surface measured on mo/day/yr 7-19-91

Pump test data: Well water was ft. after hours pumping gpm

Est. Yield gpm: Well water was ft. after hours pumping gpm

Bore Hole Diameter 9 1/8" in. to 180' ft. and in. to ft.

WELL WATER TO BE USED AS: 5 Public water supply 8 Air conditioning 11 Injection well

1 Domestic 3 Feedlot 6 Oil field water supply 9 Dewatering 12 Other (Specify below)

2 Irrigation 4 Industrial 7 Lawn and garden only 10 Monitoring well

Was a chemical/bacteriological sample submitted to Department? Yes No X; If yes, mo/day/yr sample was sub-mitted Water Well Disinfected? Yes X No

5 TYPE OF BLANK CASING USED:	5 Wrought iron	8 Concrete tile	CASING JOINTS: Glued <u>X</u> Clamped
------------------------------	----------------	-----------------	---------------------------------------

1 Steel 3 RMP (SR)

2 PVC 4 ABS

6 Asbestos-Cement 9 Other (specify below)

7 Fiberglass

Welded

Threaded

Blank casing diameter in. to ft. Dia in. to ft. Dia in. to ft.

Casing height above land surface 18" in., weight lbs./ft. Wall thickness or gauge No. SOR 21

TYPE OF SCREEN OR PERFORATION MATERIAL:

1 Steel 3 Stainless steel

5 Fiberglass

7 PVC 8 RMP (SR)

10 Asbestos-cement

2 Brass 4 Galvanized steel

6 Concrete tile

9 ABS

11 Other (specify)

12 None used (open hole)

SCREEN OR PERFORATION OPENINGS ARE:

1 Continuous slot 3 Mill slot

5 Gauzed wrapped

8 Saw cut

11 None (open hole)

2 Louvered shutter 4 Key punched

6 Wire wrapped

9 Drilled holes

7 Torch cut

10 Other (specify)

SCREEN-PERFORATED INTERVALS: From 160' ft. to 180' ft. From ft. to ft.

From ft. to ft. From ft. to ft.

GRAVEL PACK INTERVALS: From 24' ft. to 80' ft. From 92' ft. to 180' ft.

From ft. to ft. From ft. to ft.

6 GROUT MATERIAL:	1 Neat cement	2 Cement grout	<u>3 Bentonite</u>	4 Other
-------------------	---------------	----------------	--------------------	---------

Grout Intervals: From 4' ft. to 24' ft. From 30' ft. to 92' ft. From ft. to ft.

What is the nearest source of possible contamination:

1 Septic tank 4 Lateral lines

7 Pit privy

10 Livestock pens

14 Abandoned water well

2 Sewer lines

5 Cess pool

8 Sewage lagoon

11 Fuel storage

15 Oil well/Gas well

3 Watertight sewer lines 6 Seepage pit

9 Feedyard

12 Fertilizer storage

16 Other (specify below)

13 Insecticide storage

Direction from well? NortheastHow many feet? 75'

FROM	TO	LITHOLOGIC LOG	FROM	TO	PLUGGING INTERVALS
0	20	Dark topsoil - med. Sand			
20	40	Fine to med. Sand - caliche layers			
40	60	" " " "			
60	80	Med. sand & brown clay layers			
80	100	" " " "			
100	120	med. sand			
120	140	med to coarse sand			
140	160	" " "			
160	180	" " "			

7 CONTRACTOR'S OR LANDOWNER'S CERTIFICATION: This water well was <u>(1) constructed</u> , (2) reconstructed, or (3) plugged under my jurisdiction and was completed on (mo/day/year) <u>7-19-91</u> and this record is true to the best of my knowledge and belief. Kansas Water Well Contractor's License No. <u>533</u> This Water Well Record was completed on (mo/day/yr) <u>10-10-91</u> under the business name of <u>Jantzen Water Well Repair</u> by (signature) <u>[Signature]</u>

INSTRUCTIONS: Use typewriter or ball point pen. PLEASE PRESS FIRMLY and PRINT clearly. Please fill in blanks, underline or circle the correct answers. Send top three copies to Kansas Department of Health and Environment, Bureau of Water, Topeka, Kansas 66620-0001. Telephone: 913-296-5545. Send one to WATER WELL OWNER and retain one for your records.