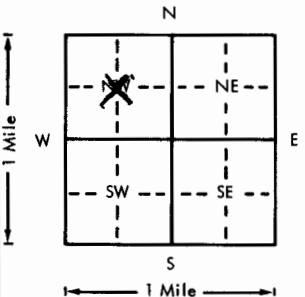


USE TYPEWRITER OR BALL
POINT PEN-PRESS FIRMLY,
PRINT CLEARLY.

WATER WELL RECORD
KSA 82a-1201-1215

Kansas Department of Health and
Environment-Division of Environment
(Water well Contractors)
Topeka, Kansas 66620

1. Location of well:		County Ford	Fraction C 1/4 NW 1/4	Section number 6	Township number T 27 S	Range number R 25 E/W
2. Distance and direction from nearest town or city: 4 miles West of Dodge City on Beach Road			3. Owner of well: Nick Maybach R.R. or street: 1716-4th City, state, zip code: Dodge City, K 67801			
4. Locate with "X" in section below:		Sketch map:		6. Bore hole dia. 28 in. Completion date _____ Well depth 179 ft.		
				7. <input type="checkbox"/> Cable tool <input type="checkbox"/> Rotary <input type="checkbox"/> Driven <input type="checkbox"/> Dug <input type="checkbox"/> Hollow rod <input type="checkbox"/> Jetted <input type="checkbox"/> Bored <input checked="" type="checkbox"/> Reverse rotary		
5. Type and color of material		From	To	8. Use: <input type="checkbox"/> Domestic <input type="checkbox"/> Public supply <input type="checkbox"/> Industry <input checked="" type="checkbox"/> Irrigation <input type="checkbox"/> Air conditioning <input type="checkbox"/> Stock <input type="checkbox"/> Lawn <input type="checkbox"/> Oil field water <input type="checkbox"/> Other		
Surface		0	4	9. Casing: Material STEEL Height: Above or below Threaded <input type="checkbox"/> Welded <input checked="" type="checkbox"/> Surface 8 in. RMP <input type="checkbox"/> PVC <input type="checkbox"/> Weight _____ lbs./ft.		
Clay		4	21	Dia. 16 in. to 137 ft. depth Wall Thickness: inches or Dia. _____ in. to _____ ft. depth Gauge No. 188		
Dry Sand		21	27	10. Screen: Manufacturer's name W.R. Brown Type Bridge Dia. 16 Slot/gauze 18 Length _____ Set between 37 ft. and 137 ft. ft. and _____ ft.		
Clay		27	31	Gravel pack? yes Size range of material 1/2 down		
Sand & Gravel		31	133	11. Static water level: _____ mo./day/yr. 38 ft. below land surface Date 4/15/76		
Clay & Sand layers		133	139	12. Pumping level below land surfaces: 46 ft. after 2 hrs. pumping 1100 g.p.m. _____ ft. after _____ hrs. pumping _____ g.p.m. Estimated maximum yield 1500 g.p.m.		
Fine sand layer Clay & Sand		139	175	13. Water sample submitted: _____ mo./day/yr. <input type="checkbox"/> Yes <input checked="" type="checkbox"/> No Date _____		
Blue Shale		175	179	14. Well head completion: _____ Pitless adapter _____ Inches above grade		
				15. Well grouted? yes With: _____ Neat cement _____ Bentonite <input checked="" type="checkbox"/> Concrete Depth: From 0 ft. to 10 ft.		
				16. Nearest source of possible contamination: _____ ft. _____ Direction 1/2 mile-type dump Well disinfected upon completion? <input type="checkbox"/> Yes <input type="checkbox"/> No		
				17. Pump: _____ Not installed Manufacturer's name Hydro Model number _____ HP _____ Volts _____ Length of drop pipe 140 ft. capacity 100 g.p.m. Type: _____ <input type="checkbox"/> Submersible <input checked="" type="checkbox"/> Turbine <input type="checkbox"/> Jet <input type="checkbox"/> Reciprocating <input type="checkbox"/> Centrifugal <input type="checkbox"/> Other		
18. Elevation:		19. Remarks:		20. Water well contractor's certification: This well was drilled under my jurisdiction and this report is true to the best of my knowledge and belief. J.O. Johnson Drilling 183 Business name _____ License No. _____ Address _____ Signed Janice Alder Date 4/26 Authorized representative		