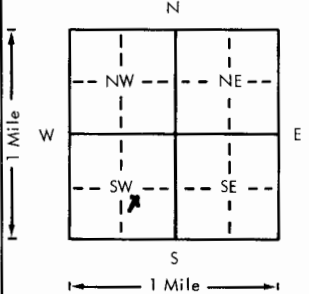


USE TYPEWRITER OR BALL
POINT PEN-PRESS FIRMLY,
PRINT CLEARLY.

WATER WELL RECORD
KSA 82a-1201-1215

Kansas Department of Health and
Environment-Division of Environment
(Water well Contractors)
Topeka, Kansas 66620

1. Location of well:		County Frod	Fraction NW1/4 SE1/4 SW/4	Section number 7	Township number T 27 S	Range number R 25 E/W
2. Distance and direction from nearest town or city: Suncrest Addition Street address of well location if in city: SW City limits Highway 50			3. Owner of well: Harry York R.R. or street: Suncrest Addition City, state, zip code: Dodge City, Ks 67801			
4. Locate with "X" in section below: Sketch map: 			6. Bore hole dia. 8 in. Completion date 9-21-78 Well depth 150			
5. Type and color of material			7. <input type="checkbox"/> Cable tool <input checked="" type="checkbox"/> Rotary <input type="checkbox"/> Driven <input type="checkbox"/> Dug <input type="checkbox"/> Hollow rod <input type="checkbox"/> Jetted <input type="checkbox"/> Bored <input type="checkbox"/> Reverse rotary			
			8. Use: <input checked="" type="checkbox"/> Domestic <input type="checkbox"/> Public supply <input type="checkbox"/> Industry <input type="checkbox"/> Irrigation <input type="checkbox"/> Air conditioning <input type="checkbox"/> Stock <input type="checkbox"/> Lawn <input type="checkbox"/> Oil field water <input type="checkbox"/> Other			
			9. Casing: Material Plastic Height: Above or *** Threaded <input type="checkbox"/> Welded <input type="checkbox"/> Surface 18 in. RMP <input type="checkbox"/> PVC Glue Weight <input type="checkbox"/> lbs./ft. Dia. 5 in. to 130 ft. depth Wall Thickness: inches or Dia. <input type="checkbox"/> in. to <input type="checkbox"/> ft. depth Gauge No. 250			
			10. Screen: Manufacturer's name Jess & Lowell Type Plastic Dia. 5" Slot/gauge 1/4" Length 20' Set between 130 ft. and 150 ft. Gravel pack? yes Range of material 1/4"			
			11. Static water level: N/A mo./day/yr. 35 ft. below land surface Date 9-21-78			
(Use a second sheet if needed)			12. Pumping level below land surfaces: N/A ____ ft. after ____ hrs. pumping ____ g.p.m. ____ ft. after ____ hrs. pumping ____ g.p.m. Estimated maximum yield ____ g.p.m.			
			13. Water sample submitted: ____ mo./day/yr. Yes <input checked="" type="checkbox"/> No <input type="checkbox"/> Date ____			
			14. Well head completion: ____ Pitless adapter 18" Inches above grade			
			15. Well grouted? yes With: <input checked="" type="checkbox"/> Neat cement <input type="checkbox"/> Bentonite <input type="checkbox"/> Concrete Depth: From 0 ft. to 20 ft.			
			16. Nearest source of possible contamination: ft. 100 Direction SW Type Septic Well disinfected upon completion? <input checked="" type="checkbox"/> Yes <input type="checkbox"/> No			
18. Elevation: Level Topography: <input checked="" type="checkbox"/> Hill <input checked="" type="checkbox"/> Slope <input checked="" type="checkbox"/> Upland <input checked="" type="checkbox"/> Valley			17. Pump: <input checked="" type="checkbox"/> Not installed Manufacturer's name ____ Model number ____ HP ____ Volts ____ Length of drop pipe ____ ft. capacity ____ g.p.m. Type: <input type="checkbox"/> Submersible <input type="checkbox"/> Turbine <input type="checkbox"/> Jet <input type="checkbox"/> Reciprocating <input type="checkbox"/> Centrifugal <input type="checkbox"/> Other			
			20. Water well contractor's certification: This well was drilled under my jurisdiction and this report is true to the best of my knowledge and belief. Cragg Well Drilling 111 Business name License No. Address Dodge City, Ks 67801 Signed: Harry York Date 9-21-78 Authorized representative			
			19. Remarks:			
			20. Water well contractor's certification:			
			20. Water well contractor's certification:			

22 250 W 7 NWSE SW
1/4 1/4 1/4