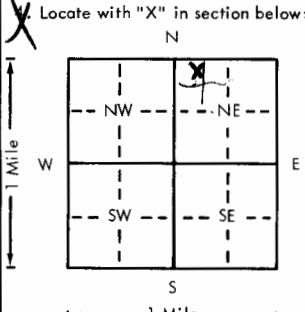


USE TYPEWRITER OR BALL
POINT PEN-PRESS FIRMLY,
PRINT CLEARLY.

WATER WELL RECORD
KSA 82a-1201-1215

Kansas Department of Health and
Environment-Division of Environment
(Water well Contractors)
Topeka, Kansas 66620

1. Location of well: County <u>Ford</u> NE NW NE SW NW NE SW NW NE Section number <u>10</u> Township number T <u>27</u> S Range number R <u>25</u> <u>EA</u>			
2. Distance and direction from nearest town or city: <u>2 mile west of</u> <u>on highway 56-1 mile south</u> Street address of well location if in city:		3. Owner of well: <u>Don Miller</u> R.R. or street: <u>RR 1</u> City, state, zip code: <u>Dodge City, Ks 67801</u>	
4. Locate with "X" in section below: 		6. Bore hole dia. <u>8"</u> in. Completion date <u>4-7-79</u> Well depth <u>120</u> ft.	
5. Type and color of material		7. <input checked="" type="checkbox"/> Cable tool <input checked="" type="checkbox"/> Rotary <input type="checkbox"/> Driven <input type="checkbox"/> Dug <input type="checkbox"/> Hollow rod <input type="checkbox"/> Jetted <input type="checkbox"/> Bored <input type="checkbox"/> Reverse rotary	
Soil		8. Use: <input checked="" type="checkbox"/> Domestic <input type="checkbox"/> Public supply <input type="checkbox"/> Industry <input type="checkbox"/> Irrigation <input type="checkbox"/> Air conditioning <input type="checkbox"/> Stock <input type="checkbox"/> Lawn <input type="checkbox"/> Oil field water <input type="checkbox"/> Other	
Sandy clay		9. Casing: Material <u>Plastic</u> Height: Above or below Threaded <input type="checkbox"/> Welded <input type="checkbox"/> Surface <u>18</u> in. RMP <input type="checkbox"/> PVC <u>Glue</u> Weight <u>250</u> lbs./ft. Dia. <u>5</u> in. to <u>100</u> depth Wall thickness: inches or Dia. <u>5</u> in. to <u>100</u> ft. depth gage No. <u>250</u>	
Gravel		10. Screen: Manufacturer's name <u>Jess & Lowell</u> Type <u>Plastic</u> Dia. <u>5"</u> Slot/gauge <u>1/4</u> Length <u>20'</u> Set between <u>100</u> ft. and <u>120</u> ft. ft. and <u>120</u> ft. Gravel pack? <u>yes</u> Size range of material <u>1/4</u>	
		11. Static water level: <u>150</u> ft. below land surface Date <u>4-7-79</u> mo./day/yr.	
		12. Pumping level below land surfaces: <u>N/A</u> ft. after hrs. pumping g.p.m. ft. after hrs. pumping g.p.m. Estimated maximum yield <u>20</u> g.p.m.	
		13. Water sample submitted: <u>Yes</u> <input checked="" type="checkbox"/> No <input type="checkbox"/> Date	
		14. Well head completion: <input checked="" type="checkbox"/> Pitless adapter <u>12</u> inches above grade	
		15. Well grouted? <u>yes</u> With: <input checked="" type="checkbox"/> Neat cement <input type="checkbox"/> Bentonite <input type="checkbox"/> Concrete Depth: From <u>3</u> ft. to <u>13</u> ft.	
		16. Nearest source of possible contamination: ft. <u>120'</u> Direction <u>NE</u> Type <u>cess pool</u> Well disinfected upon completion? <input checked="" type="checkbox"/> Yes <input type="checkbox"/> No	
		17. Pump: Manufacturer's name <u>Dempster</u> Model number <u>HF2100S2</u> HP <u>1</u> Volts <u>220</u> Length of drop pipe <u>100</u> ft. capacity g.p.m. Type: <input checked="" type="checkbox"/> Submersible <input type="checkbox"/> Turbine <input type="checkbox"/> Jet <input type="checkbox"/> Reciprocating <input type="checkbox"/> Centrifugal <input type="checkbox"/> Other	
18. Elevation:		19. Remarks:	
Level Topography: <input checked="" type="checkbox"/> Hill <input checked="" type="checkbox"/> Slope <input type="checkbox"/> Upland <input type="checkbox"/> Valley		(Use a second sheet if needed)	
		20. Water well contractor's certification: This well was drilled under my jurisdiction and this report is true to the best of my knowledge and belief. <u>Cragg Well Drilling</u> <u>111</u> Business name License No. Address <u>Dodge City, Ks 67801</u> Signed <u>Ray Oley</u> Date <u>8/2/79</u> Authorized representative	