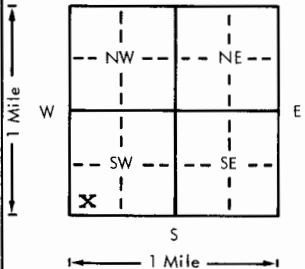


USE TYPEWRITER OR BALL
POINT PEN-PRESS FIRMLY,
PRINT CLEARLY.

WATER WELL RECORD
KSA 82a-1201-1215

Kansas Department of Health and
Environment-Division of Environment
(Water well Contractors)
Topeka, Kansas 66620

1. Location of well:		County Ford	Fraction SW 1/4 SW 1/4 SW 1/4	Section number 11	Township number T 27 S	Range number R 25 E
2. Distance and direction from nearest town or city: 2S of 56 Hwy on 14th street in Dodge City, Ks.				3. Owner of well: Jim Schriner R.R. or street: 135 W. Market City, state, zip code: Dodge City, Kansas 67801		
4. Locate with "X" in section below:		Sketch map:		6. Bore hole dia. 8 7/8 . Completion date _____ Well depth 164 ft. 10-18-77		
				7. <input type="checkbox"/> Cable tool <input checked="" type="checkbox"/> Rotary <input type="checkbox"/> Driven <input type="checkbox"/> Dug <input type="checkbox"/> Hollow rod <input type="checkbox"/> Jetted <input type="checkbox"/> Bored <input type="checkbox"/> Reverse rotary		
5. Type and color of material		From	To	8. Use: <input checked="" type="checkbox"/> Domestic <input type="checkbox"/> Public supply <input type="checkbox"/> Industry <input type="checkbox"/> Irrigation <input type="checkbox"/> Air conditioning <input type="checkbox"/> Stock <input type="checkbox"/> Lawn <input type="checkbox"/> Oil field water <input type="checkbox"/> Other		
Clay		0	3	9. Casing: Material plastic Height: Above or below Threaded <input type="checkbox"/> Welded <input type="checkbox"/> Surface 12 in. RMP <input type="checkbox"/> PVC <input checked="" type="checkbox"/> Weight _____ lbs./ft. Dia. 5 in. to 0 ft. depth Wall Thickness: inches or Dia. 5 in. to 104 ft. depth gage No. 250		
Fine Sand		3	12	10. Screen: Manufacturer's name _____ J & L Type Plastic Dia. 5" Slot/gauze .125 Length 40 Set between 124 ft. and 164 ft. Gravel pack? <input checked="" type="checkbox"/> Size range of material CMX 5/8 to #10		
Clay		12	13	11. Static water level: _____ mo./day/yr. 93 ft. below land surface Date 10-19-77		
Fine Sand & Clay layers		13	29	12. Pumping level below land surfaces: _____ ft. after _____ hrs. pumping _____ g.p.m. _____ ft. after _____ hrs. pumping _____ g.p.m. Estimated maximum yield No test pump g.p.m.		
Fine to med. sand		29	59	13. Water sample submitted: _____ mo./day/yr. Yes <input checked="" type="checkbox"/> No <input type="checkbox"/> Date _____		
Clay		59	63	14. Well head completion: <input checked="" type="checkbox"/> Pitless adapter _____ Inches above grade		
Fine sand & clay layers		63	70	15. Well grouted? <input checked="" type="checkbox"/> With: _____ Neat cement <input type="checkbox"/> Bentonite <input checked="" type="checkbox"/> Concrete Depth: From 0 ft. to 10 ft.		
Fine to med. sand		70	77	16. Nearest source of possible contamination: ft. 3/4 direction N to Type FeedLot Well disinfected upon completion? Yes <input checked="" type="checkbox"/> No <input type="checkbox"/>		
Med. sand		77	84	17. Pump: _____ Not installed Manufacturer's name Burk Model number 155N14C HP 1 1/2 Volts 110 Length of drop pipe 126 ft. capacity 18 g.p.m. Type: <input checked="" type="checkbox"/> Submersible <input type="checkbox"/> Turbine <input type="checkbox"/> Jet <input type="checkbox"/> Reciprocating <input type="checkbox"/> Centrifugal <input type="checkbox"/> Other		
Clay streak		84	85			
Med sand to coarse gravel		85	154			
Coarse gravel		154	172			
Clay		172	175			
Fine sand		175	180			
(Use a second sheet if needed)						
18. Elevation:		19. Remarks:		20. Water well contractor's certification: This well was drilled under my jurisdiction and this report is true to the best of my knowledge and belief. Woofter Drilling Inc. 343 Business name _____ License No. _____ Address Hwy 56 Dodge City, Ks. Signed Richard Woofter Date 10/17/77 Authorized representative		
Topography: <input type="checkbox"/> Hill <input type="checkbox"/> Slope <input checked="" type="checkbox"/> Upland <input type="checkbox"/> Valley						