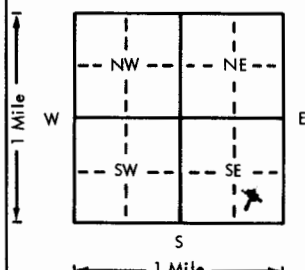


USE TYPEWRITER OR BALL
POINT PEN-PRESS FIRMLY,
PRINT CLEARLY.

WATER WELL RECORD
KSA 82a-1201-1215

Kansas Department of Health and
Environment-Division of Environment
(Water well Contractors)
Topeka, Kansas 66620

1. Location of well:		County FORD	Fraction S.E. 1/4 S.E. 1/4	Section number 11	Township number T 27-3 S	Range number R 25 E/W
2. Distance and direction from nearest town or city: 13. 1/4 W. Dodge City		3. Owner of well: Ray Broce		R.R. or street: 110 Cherry St		
Street address of well location if in city:		City, state, zip code: Dodge City, Ks 67801				
4. Locate with "X" in section below:		Sketch map:		6. Bore hole dia. 150 in. Completion date _____ Well depth 151 ft.		
				7. Cable tool _____ Rotary _____ Driven _____ Dug _____ Hollow rod _____ Jetted _____ Bored <input checked="" type="checkbox"/> Reverse rotary		
5. Type and color of material		From To		8. Use: Domestic _____ Public supply _____ Industry _____ <input checked="" type="checkbox"/> Irrigation _____ Air conditioning _____ Stock _____ Lawn _____ Oil field water _____ Other _____		
Surface		0 2		9. Casing: Material ST Height: Above or below _____ Threaded _____ Welded <input checked="" type="checkbox"/> Surface 8 in. _____ RMP _____ PVC _____ Weight _____ lbs./ft. _____ Dia. 16 in. to 150 ft. depth Wall Thickness: inches or _____ Dia. _____ in. to _____ ft. depth gage No. 79a		
Clay		2 10		10. Screen: Manufacturer's name W.A. Brown		
Sand		10 22		Type Bridge Dia. 16		
Silty Clay		22 26		Slot/gauze 1/8 Length 80'		
Sand & gravel		26 148		Set between 71 ft. and 151 ft.		
Clay		148 151		ft. and _____ ft.		
				Gravel pack? <input checked="" type="checkbox"/> Size range of material 3/4 down		
				11. Static water level: _____ mo./day/yr.		
				50 ft. below land surface Date _____		
				12. Pumping level below land surfaces:		
				_____ ft. after _____ hrs. pumping _____ g.p.m.		
				_____ ft. after _____ hrs. pumping _____ g.p.m.		
				Estimated maximum yield 1700 g.p.m.		
				13. Water sample submitted: _____ mo./day/yr.		
				Yes <input checked="" type="checkbox"/> No _____ Date _____		
				14. Well head completion:		
				Pitless adapter _____ <input checked="" type="checkbox"/> Inches above grade		
				15. Well grouted? Yes		
				With: _____ Neat cement _____ Bentonite <input checked="" type="checkbox"/> Concrete		
				Depth: From 0 ft. to 10 ft.		
				16. Nearest source of possible contamination: _____		
				ft. _____ Direction _____ Type NONE		
				Well disinfected upon completion? _____ Yes _____ No		
				17. Pump: _____ Not installed		
				Manufacturer's name WESTERLAND ROLLER		
				Model number _____ HP _____ Volts _____		
				Length of drop pipe 100 ft. capacity 700 g.p.m.		
				Type:		
				_____ Submersible <input checked="" type="checkbox"/> Turbine		
				_____ Jet _____ Reciprocating		
				_____ Centrifugal _____ Other		
18. Elevation: 2530		19. Remarks:		20. Water well contractor's certification:		
Topography: _____ Hill <input checked="" type="checkbox"/> Slope _____ Upland _____ Valley				This well was drilled under my jurisdiction and this report is true to the best of my knowledge and belief.		
				J.O. Johnson Drilling 183		
				Business name _____ License No. _____		
				Address _____		
				Signed James Alder Date 6/76		
				Authorized representative		