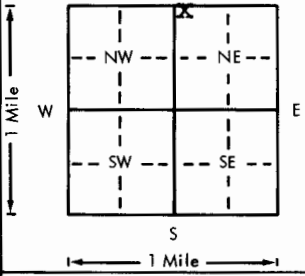


USE TYPEWRITER OR BALL
POINT PEN-PRESS FIRMLY,
PRINT CLEARLY.

WATER WELL RECORD
KSA 82a-1201-1215

Kansas Department of Health and
Environment-Division of Environment
(Water well Contractors)
Topeka, Kansas 66620

1. Location of well:		County Ford	Fraction NW 1/4 NW 1/4 NE 1/4	Section number 11	Township number T 27 S R 25 E/W	Range number 25	
2. Distance and direction from nearest town or city: 1 mi south of Dodge City Street address of well location if in city:				3. Owner of well: Ray Broce R.R. or street: 2208 East Crescent Dr. City, state, zip code: Dodge City, Kansas			
4. Locate with "X" in section below: N W E S 1 Mile		Sketch map: 		6. Bore hole dia. 28 in. Completion date 6-16-78 Well depth 209 ft.			
5. Type and color of material		From	To	7. Cable tool <input type="checkbox"/> Rotary <input type="checkbox"/> Driven <input type="checkbox"/> Dug <input type="checkbox"/> Hollow rod <input type="checkbox"/> Jetted <input type="checkbox"/> Bored <input checked="" type="checkbox"/> Reverse rotary			
Surface		0	3	8. Use: <input type="checkbox"/> Domestic <input type="checkbox"/> Public supply <input type="checkbox"/> Industry <input checked="" type="checkbox"/> Irrigation <input type="checkbox"/> Air conditioning <input type="checkbox"/> Stock <input type="checkbox"/> Lawn <input type="checkbox"/> Oil field water <input type="checkbox"/> Other			
Fine sand and clay		3	15	9. Casing: Material metal Height: Above or below Threaded <input type="checkbox"/> Welded <input checked="" type="checkbox"/> Surface 12 in. RMP <input type="checkbox"/> PVC <input type="checkbox"/> Weight 31.66 lbs./ft.			
Coarse sand and gravel		15	56	Dia. 16 in. to 209 ft. depth Wall Thickness: inches or Dia. <input type="checkbox"/> in. to <input type="checkbox"/> ft. depth gage No. .188			
Brown coleche clay		56	88	10. Screen: Manufacturer's name W. A. Brown Type 17% Free-flow Dia. 16 Slot/gauze 1/8 Length 171 Set between 38 ft. and 209 ft. ft. and <input type="checkbox"/> ft.			
Fine to med. sand and gravel with 10% clay mixed		88	100	Gravel pack? yes Size range of material 3/8 down			
Yellow clay		100	121	11. Static water level: <input type="checkbox"/> mo./day/yr. 43 ft. below land surface Date 12-16-77			
Good med. sand and gravel		121	132	12. Pumping level below land surfaces: 155 ft. after 3 hrs. pumping 1250 g.p.m. 170 ft. after 3 hrs. pumping 1500 g.p.m. Estimated maximum yield 1750 g.p.m.			
Clay and sandy clay		132	143	13. Water sample submitted: <input type="checkbox"/> Yes <input checked="" type="checkbox"/> No Date <input type="checkbox"/> mo./day/yr.			
Good fine to med. bottom gravel		143	175	14. Well head completion: <input type="checkbox"/> Pitless adapter <input checked="" type="checkbox"/> Inches above grade			
Yellow and gray clay		175	180	15. Well grouted? yes With: <input type="checkbox"/> Neat cement <input type="checkbox"/> Bentonite <input checked="" type="checkbox"/> Concrete Depth: From 0 ft. to 10 ft.			
Brown and purple sandstone-Good		180	205	16. Nearest source of possible contamination: field ft. <input type="checkbox"/> Direction <input type="checkbox"/> Type field Well disinfected upon completion? <input type="checkbox"/> Yes <input checked="" type="checkbox"/> No			
Yellow clay and gray shale		205	210	17. Pump: <input checked="" type="checkbox"/> Not installed Manufacturer's name <input type="checkbox"/> Model number <input type="checkbox"/> HP <input type="checkbox"/> Volts <input type="checkbox"/> Length of drop pipe <input type="checkbox"/> ft. capacity <input type="checkbox"/> g.p.m. Type: <input type="checkbox"/> Submersible <input type="checkbox"/> Turbine <input type="checkbox"/> Jet <input type="checkbox"/> Reciprocating <input type="checkbox"/> Centrifugal <input type="checkbox"/> Other			
(Use a second sheet if needed)							
18. Elevation:		19. Remarks:		20. Water well contractor's certification: This well was drilled under my jurisdiction and this report is true to the best of my knowledge and belief. Ace-Hi International 190 Business name License No. Address Dodge City, Kansas Signed Paul C. Giffith Date 6-16-78 Authorized representative			
Topography: <input type="checkbox"/> Hill <input type="checkbox"/> Slope <input type="checkbox"/> Upland <input checked="" type="checkbox"/> Valley							