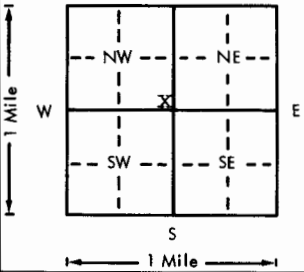


USE TYPEWRITER OR BALL  
POINT PEN-PRESS FIRMLY,  
PRINT CLEARLY.

WATER WELL RECORD  
KSA 82a-1201-1215

Kansas Department of Health and  
Environment-Division of Environment  
(Water well Contractors)  
Topeka, Kansas 66620

|  |                       |   |   |                                  |                                 |
|--|-----------------------|---|---|----------------------------------|---------------------------------|
| 1. Location of well:   | County<br><u>Ford</u> | Fraction<br><u>SE 1/4 SE 1/4 NW 1/4</u> | Section number<br><u>14</u>   | Township number<br><u>T 27 S</u> | Range number<br><u>R 25 E/W</u> |
| 2. Distance and direction from nearest town or city:<br><u>2 1/2 south-1/4 east of Dodge City</u><br>Street address of well location if in city:   |                       |   | 3. Owner of well: <u>George Wiseman</u><br>R.R. or street: <u>RFD 3</u><br>City, state, zip code: <u>Dodge City, Kansas</u>   |                                  |                                 |
| 4. Locate with "X" in section below:<br>N<br><br>W<br>E<br>S<br>1 Mile   |                       |   | Sketch map:<br>6. Bore hole dia. <u>176</u> in. Completion date <u>9-13-76</u><br>Well depth <u>176</u> ft.<br>7. <input type="checkbox"/> Cable tool <input type="checkbox"/> Rotary <input type="checkbox"/> Driven <input type="checkbox"/> Dug<br><input type="checkbox"/> Hollow rod <input type="checkbox"/> Jetted <input type="checkbox"/> Bored <input checked="" type="checkbox"/> Reverse rotary<br>8. Use: <input type="checkbox"/> Domestic <input type="checkbox"/> Public supply <input type="checkbox"/> Industry<br><input checked="" type="checkbox"/> Irrigation <input type="checkbox"/> Air conditioning <input type="checkbox"/> Stock<br><input type="checkbox"/> Lawn <input type="checkbox"/> Oil field water <input type="checkbox"/> Other<br>9. Casing: Material <u>Metal</u> Height: Above or below<br>Threaded <input type="checkbox"/> Welded <input checked="" type="checkbox"/> Surface <u>10</u> in.<br>RMP <u>16</u> PVC <input type="checkbox"/> Weight <u>31.66</u> lbs./ft.<br>Dia. <u>16</u> in. to <u>176</u> ft. depth Wall Thickness: inches or<br>Dia. <u>16</u> in. to <u>176</u> ft. depth gage No. <u>188</u> |                                  |                                 |
| 5. Type and color of material  |                       |   | From  | To                               |                                 |
| <u>Surface</u>   |                       |   | <u>0</u>  | <u>3</u>                         |                                 |
| <u>Brown sand</u>  |                       |   | <u>3</u>  | <u>7</u>                         |                                 |
| <u>Fine to med. sand and gravel</u>  |                       |   | <u>7</u>  | <u>13</u>                        |                                 |
| <u>Fine sand</u>   |                       |   | <u>13</u>   | <u>50</u>                        |                                 |
| <u>Sandy brown clay</u>  |                       |   | <u>50</u>   | <u>62</u>                        |                                 |
| <u>Good sand and gravel with some clay mixed</u>   |                       |   | <u>62</u>   | <u>68</u>                        |                                 |
| <u>Good med. sand and gravel</u>   |                       |   | <u>68</u>   | <u>105</u>                       |                                 |
| <u>Good coarse sand and gravel</u>   |                       |   | <u>105</u>  | <u>132</u>                       |                                 |
| <u>Cemented sand and gravel and hard rock</u>  |                       |   | <u>132</u>  | <u>140</u>                       |                                 |
| <u>Good fine to med. sand and gravel</u>   |                       |   | <u>140</u>  | <u>150</u>                       |                                 |
| <u>" " " " " " " " with some clay</u>  |                       |   | <u>150</u>  | <u>166</u>                       |                                 |
| <u>Brown and yellow clay</u>   |                       |   | <u>166</u>  | <u>187</u>                       |                                 |
| <u>Blue shale</u>  |                       |   | <u>187</u>  | <u>195</u>                       |                                 |
| (Use a second sheet if needed)   |                       |   |   |                                  |                                 |
| 18. Elevation:<br><u>2500</u><br>Topography:<br><input type="checkbox"/> Hill<br><input type="checkbox"/> Slope<br><input checked="" type="checkbox"/> Upland<br><input type="checkbox"/> Valley | 19. Remarks:          |   | 20. Water well contractor's certification:<br>This well was drilled under my jurisdiction and this report is true to the best of my knowledge and belief.<br><u>Ace-Hi International</u> <u>190</u><br>Business name License No.<br>Address <u>Dodge City, Kansas</u><br>Signed <u>Carl C. Jital</u> Date <u>9-13-76</u><br>Authorized representative   |                                  |                                 |

22 2500 14 SEE ENW  
1/4 1/4 1/4