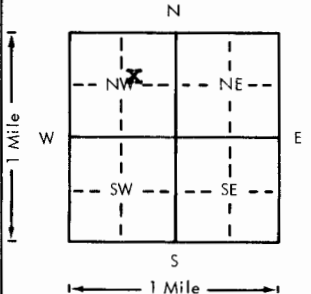


USE TYPEWRITER OR BALL  
POINT PEN-PRESS FIRMLY,  
PRINT CLEARLY.

WATER WELL RECORD  
KSA 82a-1201-1215

Kansas Department of Health and  
Environment-Division of Environment  
(Water well Contractors)  
Topeka, Kansas 66620

BAC

1. Location of well:		County <b>Ford</b>	Fraction <b>SW 1/4 NE 1/4 NW 1/4</b>	Section number <b>17</b>	Township number <b>T 27 S</b>	Range number <b>R 25 E</b>
2. Distance and direction from nearest town or city: <b>1 1/2 south-2-3/4 west Dodge City, Ks</b>				3. Owner of well: <b>Mike Schneweis</b> R.R. or street: <b>RFD 1</b> City, state, zip code: <b>Dodge City, Kansas</b>		
4. Locate with "X" in section below:		Sketch map:		6. Bore hole dia. <b>28</b> in. Completion date <b>6-18-79</b> Well depth <b>203</b> ft.		
				7. Cable tool <input type="checkbox"/> Rotary <input type="checkbox"/> Driven <input type="checkbox"/> Dug <input type="checkbox"/> <input type="checkbox"/> Hollow rod <input type="checkbox"/> Jetted <input type="checkbox"/> Bored <input checked="" type="checkbox"/> Reverse rotary		
5. Type and color of material		From To		8. Use: Domestic <input type="checkbox"/> Public supply <input type="checkbox"/> Industry <input type="checkbox"/> <input checked="" type="checkbox"/> Irrigation <input type="checkbox"/> Air conditioning <input type="checkbox"/> Stock <input type="checkbox"/> <input type="checkbox"/> Lawn <input type="checkbox"/> Oil field water <input type="checkbox"/> Other		
Surface		0 3		9. Casing: Material <b>metal</b> Height: Above or below		
Sandy clay		3 7		Threaded <input type="checkbox"/> Welded <input checked="" type="checkbox"/> Surface <b>12</b> in.		
Fine sand		7 65		RMP <input type="checkbox"/> PVC <input type="checkbox"/> Weight <b>31.66</b> lbs./ft.		
Med. sand and gravel with 15% clay mixed		65 90		Dia. <b>16</b> in. to <b>203</b> ft. depth Wall thickness <b>.188</b> in.		
Good med. sand and gravel		90 120		Dia. <input type="checkbox"/> in. to <input type="checkbox"/> ft. depth gage No. <input type="checkbox"/>		
Fine to coarse sand and gravel		120 135		10. Screen: Manufacturer's name <b>W. A. Brown</b>		
Good med. sand and gravel		135 174		Type <b>17 1/2 Free-flt.</b> <b>16</b>		
Brown clay		174 188		Slot/gauze <b>1/8</b> Length <b>100</b>		
Med. sand and gravel with 30% clay mixed		188 196		Set between <b>99</b> ft. and <b>199</b> ft.		
Yellow clay		196 204		ft. and <input type="checkbox"/> ft.		
Blue shale		204 210		Gravel pack? <b>yes</b> Size range of material <b>3/8 down</b>		
				11. Static water level: <input type="checkbox"/> mo./day/yr. <b>90</b> ft. below land surface Date <b>4-3-79</b>		
				12. Pumping level below land surfaces: <b>80</b> ft. after <b>2</b> hrs. pumping <b>800</b> g.p.m. <b>110</b> ft. after <b>2</b> hrs. pumping <b>1500</b> g.p.m. Estimated maximum yield <b>2000</b> g.p.m.		
				13. Water sample submitted: <input type="checkbox"/> mo./day/yr. <input type="checkbox"/> Yes <input checked="" type="checkbox"/> No Date <input type="checkbox"/>		
				14. Well head completion: <input type="checkbox"/> Pitless adapter <input checked="" type="checkbox"/> <input type="checkbox"/> inches above grade		
				15. Well grouted? <b>yes</b> With: <input type="checkbox"/> Neat cement <input type="checkbox"/> Bentonite <input checked="" type="checkbox"/> Concrete Depth: From <b>0</b> ft. to <b>10</b> ft.		
				16. Nearest source of possible contamination: <b>field</b> ft. <input type="checkbox"/> Direction <input type="checkbox"/> Type <input type="checkbox"/> Well disinfected upon completion? <input type="checkbox"/> Yes <input checked="" type="checkbox"/> No		
				17. Pump: <input type="checkbox"/> Not installed Manufacturer's name <b>Goulds</b> Model number <b>12110</b> HP <b>100</b> Volts <input type="checkbox"/> Length of drop pipe <b>180</b> ft. capacity <b>800</b> g.p.m. Type: <input type="checkbox"/> Submersible <input checked="" type="checkbox"/> Turbine <input type="checkbox"/> Jet <input type="checkbox"/> Reciprocating <input type="checkbox"/> Centrifugal <input type="checkbox"/> Other		
18. Elevation:		19. Remarks:		20. Water well contractor's certification: This well was drilled under my jurisdiction and this report is true to the best of my knowledge and belief. <b>Ace-Hi International</b> <b>190</b> Business name <b>Dodge City, Kansas</b> License No. Address <b>Bail 607th</b> Date <b>7-11-79</b> Signed <b>Bail 607th</b> Authorized representative		