

1 LOCATION OF WATER WELL:		Fraction	Section Number			Township Number		Range Number	
County:	Ford	NW ¼ NE ¼ NE ¼	21			T 27 S		R 25 EW	


<b>1 LOCATION OF WATER WELL:</b>	Fraction	Section Number	Township Number	Range Number
County: Ford	NW ¼ NE ¼ NE ¼	21	T 27 S	R 25 E W

Distance and direction from nearest town or city street address of well if located within city?

From Dodge City, Ks. - on highway 283 - junction 156 - 2 miles West and 2½ miles South

2 WATER WELL OWNER:	Bob Schneweis	
RR#, St. Address, Box # :	Route #1	Board of Agriculture, Division of Water Resources
City, State, ZIP Code :	Dodge City, Kansas 67801	Application Number:

3 LOCATE WELL'S LOCATION WITH AN "X" IN SECTION BOX: 4 DEPTH OF COMPLETED WELL... 195... ft. ELEVATION: .....

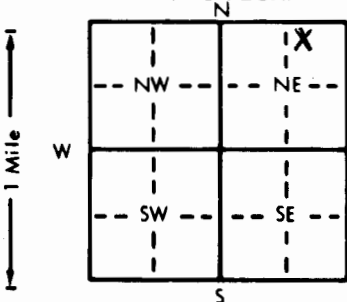

Depth(s) Groundwater Encountered 1. . . . . ft. 2. . . . . ft. 3. . . . . ft.

WELL'S STATIC WATER LEVEL 113 . . . . . ft. below land surface measured on mo/day/yr 10-3-88

Pump test data: Well water was . . . . . ft. after . . . . . hours pumping . . . . . gpm

Est. Yield 35 . . . . . gpm: Well water was . . . . . ft. after . . . . . hours pumping . . . . . gpm

Bore Hole Diameter 8 . . . . . in. to 1.95 . . . . . ft., and . . . . . in. to . . . . . ft.

WELL WATER TO BE USED AS:

1 Domestic	3 Feedlot	6 Oil field water supply	9 Dewatering	11 Injection well
2 Irrigation	4 Industrial	7 Lawn and garden only	10 Observation well	12 Other (Specify below)

Was a chemical/bacteriological sample submitted to Department? Yes . . . . . No XX . . . . .; If yes, mo/day/yr sample was submitted

Water Well Disinfected? Yes XX . . . . . No . . . . .

5	TYPE OF BLANK CASING USED:		5 Wrought iron	8 Concrete tile	CASING JOINTS: Glued <u>XX</u> . . . Clamped . . . . .
	1 Steel	3 RMP (SR)	6 Asbestos-Cement	9 Other (specify below)	Welded . . . . .
	2 PVC	4 ABS	7 Fiberglass	.....	Threaded.....

Blank casing diameter . . . 5 . . . in. to . . . 19.5 . . . ft. Dia . . . in. to . . . ft. Dia . . . in. to . . . ft.  
Casing height above land surface . . . 12 . . . in. weight . . . 200 psi . . . lbs./ft. Wall thickness or gauge No. . . SDR 21

TYPE OF SCREEN OR PERFORATION MATERIAL:			7 PVC	10 Asbestos-cement
1 Steel	3 Stainless steel	5 Fiberglass	8 RMP (SR)	11 Other (specify) .....
2 Brass	4 Galvanized steel	6 Concrete tile	9 ABS	12 None used (open hole)

SCREEN OR PERFORATION OPENINGS ARE:

1 Continuous slot	3 Mill slot	5 Gauzed wrapped	8 Saw cut	11 None (open hole)
2 Louvered shutter	4 Key punched	6 Wire wrapped	9 Drilled holes	
		7 Torch cut	10 Other (specify) .....	

SCREEN-PERFORATED INTERVALS: From 170 ft. to 190 ft., From ..... ft. to ..... ft.

	From . . . . .	ft. to . . . . .	ft., From . . . . .	ft. to . . . . .	ft.
GRAVEL PACK INTERVALS:	From . . . . . 25	ft. to . . . . . 195	ft., From . . . . .	ft. to . . . . .	ft.
	From . . . . .	ft. to . . . . .	ft., From . . . . .	ft. to . . . . .	ft.

6 GROUT MATERIAL:		1 Neat cement	2 Cement grout	3 Bentonite	4 Other <u>hole plug</u>
Grout Intervals:		From <u>0</u> ft. to <u>25</u> ft.	From <u>    </u> ft. to <u>    </u> ft.	From <u>    </u> ft. to <u>    </u> ft.	From <u>    </u> ft. to <u>    </u> ft.
What is the nearest source of possible contamination:		none		10 Livestock pens	14 Abandoned water well
1 Septic tank	4 Lateral lines	7 Pit privy	11 Fuel storage	15 Oil well/Gas well	
2 Sewer lines	5 Cess pool	8 Sewage lagoon	12 Fertilizer storage	16 Other (specify below)	
3 Watertight sewer lines	6 Seepage pit	9 Feedyard	13 Insecticide storage		
Direction from well?				How many feet?	

FROM	TO	LITHOLOGIC LOG	FROM	TO	LITHOLOGIC LOG
0	15	Top soil & clay			
15	60	Fine sand			
60	85	Clay			
85	135	Fine to medium sand			
135	140	Clay			
140	175	Fine sand			
175	178	Clay			
178	190	Fine to medium sand (very loose)			
190	195	Clay			
195	210	Blue shale			

7 CONTRACTOR'S OR LANDOWNER'S CERTIFICATION: This water well was (1) constructed, (2) reconstructed, or (3) plugged under my jurisdiction and was completed on (mo/day/year) October 12, 1988 and this record is true to the best of my knowledge and belief. Kansas Water Well Contractor's License No. 179 This Water Well Record was completed on (mo/day/yr) 10-21-88 under the business name of Joe's Well Service, Inc. Cimarron, Ks. by (signature) Joseph Creek

INSTRUCTIONS: Use typewriter or ball point pen. PLEASE PRESS FIRMLY and PRINT clearly. Please fill in blanks, underline or circle the correct answers. Send top three copies to Kansas Department of Health and Environment, Bureau of Water Protection, Topeka, Kansas 66620-7320, Telephone: 913-862-9360. Send one to WATER WELL OWNER and retain one for your records.