


USE TYPEWRITER OR BALL POINT PEN-PRESS FIRMLY, PRINT CLEARLY.

WATER WELL RECORD  
KSA 82a-1201-1215

Kansas Department of Health and Environment-Division of Environment (Water well Contractors) Topeka, Kansas 66620

1. Location of well: County Ford Fraction Center 1/4 NE 1/4 Section number 23 Township number T 27 S Range number R 25 E/W

2. Distance and direction from nearest town or city: 3 1/2 1/4 W Dodge City  
Street address of well location if in city:  
3. Owner of well: Ralph Monger  
R.R. or street: 2007 E. Lane  
City, state, zip code: Dodge City, Ks 67801

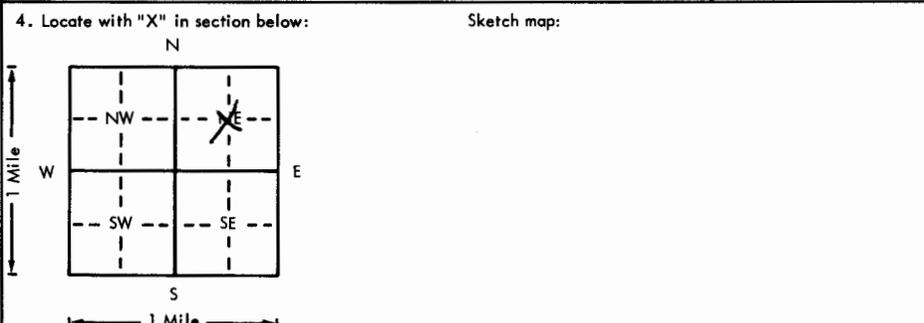

6. Bore hole dia 7 1/2 in. Completion date \_\_\_\_\_  
Well depth 165 ft.  
7. Cable tool  Rotary  Driven  Dug  
 Hollow rod  Jetted  Bored  Reverse rotary  
8. Use: Domestic  Public supply  Industry  
 Irrigation  Air conditioning  Stock  
 Lawn  Oil field water  Other  
9. Casing: Material Steel Height: Above or below  
Threaded  Welded  Surface 8 in.  
RMP \_\_\_\_\_ PVC \_\_\_\_\_ Weight \_\_\_\_\_ lbs./ft.  
Dia. 16 in. to 17 1/2 ft. depth; Wall thickness: inches or  
Dia. \_\_\_\_\_ in. to \_\_\_\_\_ ft. depth; gage No. 188

5. Type and color of material	From	To
<u>surface</u>	<u>0</u>	<u>2</u>
<u>Clay</u>	<u>2</u>	<u>25</u>
<u>silty clay</u>	<u>25</u>	<u>31</u>
<u>dry sand</u>	<u>31</u>	<u>70</u>
<u>Clay</u>	<u>70</u>	<u>98</u>
<u>sand &amp; gravel</u>	<u>98</u>	<u>103</u>
<u>Clay &amp; sand layers</u>	<u>103</u>	<u>105</u>
<u>sand &amp; gravel</u>	<u>105</u>	<u>165</u>
	<u>165</u>	

10. Screen: Manufacturer's name W.A. Brown  
Type Bridge Dia. 16  
Slot/gauze 1/8 Length \_\_\_\_\_  
Set between 112 ft. and 172 ft.  
\_\_\_\_\_ ft. and \_\_\_\_\_ ft.  
Gravel pack? yes Size range of material 1/2 down  
11. Static water level: \_\_\_\_\_ mo./day/yr.  
99 ft. below land surface Date 2/9/76  
12. Pumping level below land surfaces:  
124 ft. after 2 hrs. pumping 1100 g.p.m.  
\_\_\_\_\_ ft. after \_\_\_\_\_ hrs. pumping \_\_\_\_\_ g.p.m.  
Estimated maximum yield 1250 g.p.m.  
13. Water sample submitted: \_\_\_\_\_ mo./day/yr.  
Yes  No  Date \_\_\_\_\_  
14. Well head completion: \_\_\_\_\_ Inches above grade  
 Pitless adapter  
15. Well grouted? yes  
With:  Neat cement  Bentonite  Concrete  
Depth: From 0 ft. to 10 ft.  
16. Nearest source of possible contamination: NONE  
ft. \_\_\_\_\_ Direction \_\_\_\_\_ Type \_\_\_\_\_  
Well disinfected upon completion? \_\_\_\_\_ Yes \_\_\_\_\_ No  
17. Pump: \_\_\_\_\_ Not installed  
Manufacturer's name Western Land Roller  
Model number \_\_\_\_\_ HP \_\_\_\_\_ Volts \_\_\_\_\_  
Length of drop pipe 160 ft. capacity 1100 g.p.m.  
Type: \_\_\_\_\_  
 Submersible  Turbine  
 Jet  Reciprocating  
 Centrifugal  Other

18. Elevation: \_\_\_\_\_  
19. Remarks: \_\_\_\_\_  
20. Water well contractor's certification:  
This well was drilled under my jurisdiction and this report is true to the best of my knowledge and belief.  
J.O. Johnson Drilling License No. \_\_\_\_\_  
Business name \_\_\_\_\_  
Address \_\_\_\_\_  
Signed Janice Alder Date 6/76  
Authorized representative

27 250 23 CNE 1/4 1/4 1/4