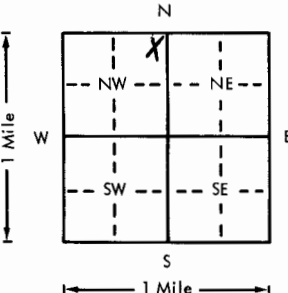
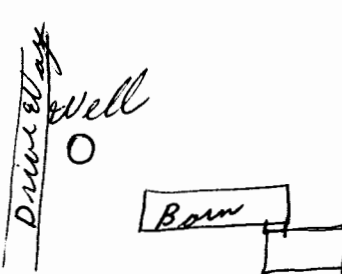


USE TYPEWRITER OR BALL  
POINT PEN-PRESS FIRMLY,  
PRINT CLEARLY.

WATER WELL RECORD  
KSA 82a-1201-1215

Kansas Department of Health and  
Environment-Division of Environment  
(Water well Contractors)  
Topeka, Kansas 66620

Well #2

|  |  |                       |   |   |                                |                                   |
|--|--|-----------------------|---|---|--------------------------------|-----------------------------------|
| 1. Location of well:   |  | County<br><b>Ford</b> | Fraction<br><b>NE 1/4 NE 1/4 NE 1/4</b> | Section number<br><b>35</b>   | Township number<br><b>T 27</b> | Range number<br><b>S R 25 E/W</b> |
| 2. Distance and direction from nearest town or city: <b>5 miles south &amp; 1/4 mile west of Dodge City, Kansas</b><br>Street address of well location if in city: |  |                       |   | 3. Owner of well: <b>Duane R. Million</b><br>R.R. or street: <b>R.F.D. #1</b><br>City, state, zip code: <b>Dodge City, Kansas 67801</b>   |                                |                                   |
| 4. Locate with "X" in section below:<br>   |  |                       |   | Sketch map:<br>  |                                |                                   |
| 5. Type and color of material  |  |                       |   | From  | To                             |                                   |
| Top soil & cleecy  |  |                       |   | 0   | 15                             |                                   |
| Cleecy & clay layers   |  |                       |   | 15  | 30                             |                                   |
| Clay   |  |                       |   | 30  | 45                             |                                   |
| Clay & medium sand   |  |                       |   | 45  | 60                             |                                   |
| Medium sand & clay   |  |                       |   | 60  | 75                             |                                   |
| Medium sand  |  |                       |   | 75  | 105                            |                                   |
| Coarse sand & clay   |  |                       |   | 105   | 120                            |                                   |
| Coarse sand  |  |                       |   | 120   | 150                            |                                   |
| Coarse sand & clay layers  |  |                       |   | 150   | 165                            |                                   |
| Coarse sand & clay layers  |  |                       |   | 165   | 180                            |                                   |
| Coarse sand & clay layers  |  |                       |   | 180   | 210                            |                                   |
| Coarse sand  |  |                       |   | 210   | 225                            |                                   |
| Coarse sand & clay layers  |  |                       |   | 225   | 240                            |                                   |
| (Use a second sheet if needed)   |  |                       |   |   |                                |                                   |
| 18. Elevation:   |  | 19. Remarks:          |   | 20. Water well contractor's certification:<br>This well was drilled under my jurisdiction and this report is true to the best of my knowledge and belief.<br><b>Joe's Well Serie 179</b><br>Business name <b>Box 174 Cimarron, Ks.</b> License No. <b>179</b><br>Address <b>Box 174 Cimarron, Ks.</b><br>Signed <b>Larry Crick</b> Date <b>6-16-77</b><br>Authorized representative |                                |                                   |
| Topography:<br>Hill<br>Slope<br><b>XX</b> Upland<br>Valley   |  |                       |   |   |                                |                                   |

22  
250  
35  
1/4 1/4 1/4  
NE NE NE