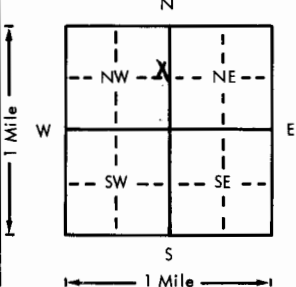
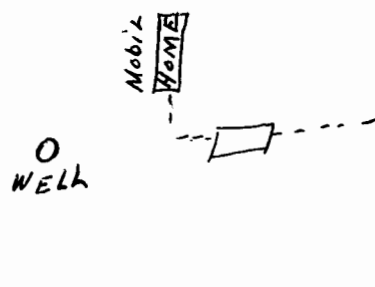


USE TYPEWRITER OR BALL  
POINT PEN-PRESS FIRMLY,  
PRINT CLEARLY.

WATER WELL RECORD  
KSA 82a-1201-1215

Kansas Department of Health and  
Environment-Division of Environment  
(Water well Contractors)  
Topeka, Kansas 66620

1. Location of well:		County <b>Ford</b>	Fraction <b>SE 1/4 NE 1/4 NW 1/4</b>	Section number <b>35</b>	Township number <b>T 27 S</b>	Range number <b>R 25 E</b>
2. Distance and direction from nearest town or city: <b>5 miles south &amp; 1/2 miles west of Dodge City, Kansas</b> Street address of well location if in city:				3. Owner of well: <b>Bill Kortz</b> R.R. or street: <b>Route #3</b> City, state, zip code: <b>Dodge City, Kansas 67801</b>		
4. Locate with "X" in section below:		Sketch map:		6. Bore hole dia. <b>8</b> in. Completion date <b>5-12-77</b> Well depth <b>235</b> ft.		
				7. <input checked="" type="checkbox"/> Cable tool <input checked="" type="checkbox"/> Rotary <input type="checkbox"/> Driven <input type="checkbox"/> Dug <input type="checkbox"/> Hollow rod <input type="checkbox"/> Jetted <input type="checkbox"/> Bored <input type="checkbox"/> Reverse rotary		
5. Type and color of material				8. Use: <input checked="" type="checkbox"/> Domestic <input type="checkbox"/> Public supply <input type="checkbox"/> Industry <input type="checkbox"/> Irrigation <input type="checkbox"/> Air conditioning <input type="checkbox"/> Stock <input type="checkbox"/> Lawn <input type="checkbox"/> Oil field water <input type="checkbox"/> Other		
				9. Casing: Material <b>RMP</b> Height: Above or below <b>XX</b> Threaded <input type="checkbox"/> Welded <input type="checkbox"/> Surface <b>12</b> in. RMP <b>XX</b> PVC <input type="checkbox"/> Weight <input type="checkbox"/> lbs./ft. Dia. <b>5</b> in. to <b>235</b> ft. depth Wall Thickness: inches or Dia. <input type="checkbox"/> in. to <input type="checkbox"/> ft. depth gage No. <b>250</b>		
				10. Screen: Manufacturer's name <b>Sunflower</b> Type <b>RMP</b> Dia. <b>5"</b> Slot/gage <b>1/8"</b> Length <b>20</b> ft. Set between <b>210</b> ft. and <b>230</b> ft. ft. and <input type="checkbox"/> ft. Gravel pack? <b>yes</b> Size range of material <b>1/4"</b>		
				11. Static water level: <input type="checkbox"/> mo./day/yr. <b>154</b> ft. below land surface Date <b>5-12-77</b>		
				12. Pumping level below land surfaces: <b>160</b> ft. after <b>1 1/2</b> hrs. pumping <b>50</b> g.p.m. <input type="checkbox"/> ft. after <input type="checkbox"/> hrs. pumping <input type="checkbox"/> g.p.m. Estimated maximum yield <b>70</b> g.p.m.		
				13. Water sample submitted: <input type="checkbox"/> mo./day/yr. Yes <input checked="" type="checkbox"/> No <input type="checkbox"/> Date <input type="checkbox"/>		
				14. Well head completion: <input checked="" type="checkbox"/> Pitless adapter <b>12</b> inches above grade		
				15. Well grouted? <b>yes</b> With: <input checked="" type="checkbox"/> Neat cement <input type="checkbox"/> Bentonite <input type="checkbox"/> Concrete Depth: From <b>7</b> ft. to <b>20</b> ft.		
				16. Nearest source of possible contamination: ft. <b>100</b> Direction <b>East</b> Type <b>Sewer</b> Well disinfected upon completion? <input checked="" type="checkbox"/> Yes <input type="checkbox"/> No		
				17. Pump: <input type="checkbox"/> Not installed Manufacturer's name <b>Flint &amp; Walling</b> Model number <b>189 15B12</b> <b>1 1/2</b> Volts <b>230</b> Length of drop pipe <b>189</b> ft. capacity <b>12</b> g.p.m. Type: <input checked="" type="checkbox"/> Submersible <input type="checkbox"/> Turbine <input type="checkbox"/> Jet <input type="checkbox"/> Reciprocating <input type="checkbox"/> Centrifugal <input type="checkbox"/> Other		
(Use a second sheet if needed)						
18. Elevation:		19. Remarks:		20. Water well contractor's certification: This well was drilled under my jurisdiction and this report is true to the best of my knowledge and belief. <b>Joe's Well Service</b> <b>179</b> Business name <b>Box 174 Cimarron, Ks.</b> License No. Address <b>10-7-77</b> Signed <b>Larry Crick</b> Date <b>10-7-77</b> Authorized representative		
Topography: <input checked="" type="checkbox"/> Hill <input type="checkbox"/> Slope <input type="checkbox"/> Upland <input type="checkbox"/> Valley		<b>Has excellent drainage to the east.</b>				

Forward the white, blue and pink copies to the Department of Health and Environment

Form WWC-5