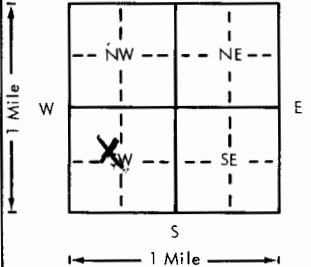


USE TYPEWRITER OR BALL
POINT PEN-PRESS FIRMLY,
PRINT CLEARLY.

WATER WELL RECORD
KSA 82a-1201-1215

Kansas Department of Health and
Environment-Division of Environment
(Water well Contractors)
Topeka, Kansas 66620

1. Location of well:		County FORD	Fraction S/E 1/4 N/W 1/4 S/W 1/4	Section number 1	Township number T 27 S R 26 E/W	Range number
2. Distance and direction from nearest town or city: DODGE CITY		3. Owner of well: Russell Johnson		Street address of well location if in city: Dodge City, KS 67801		
4. Locate with "X" in section below:		Sketch map:		6. Bore hole dia. 2 1/2 in. Completion date _____ Well depth 167 ft.		
				7. Cable tool _____ Rotary _____ Driven _____ Dug _____ Hollow rod _____ Jetted _____ Bored <input checked="" type="checkbox"/> Reverse rotary		
5. Type and color of material		From To		8. Use: Domestic _____ Public supply _____ Industry _____ <input checked="" type="checkbox"/> Irrigation _____ Air conditioning _____ Stock _____ Lawn _____ Oil field water _____ Other _____		
Surface		0 2		9. Casing: Material STEEL Height: Above or below _____ Threaded _____ Welded <input checked="" type="checkbox"/> Surface _____ in. RMP _____ PVC _____ Weight _____ lbs./ft. Dia. 16 in. to 16 7/8 ft. depth Wall Thickness: inches or _____ Dia. _____ in. to _____ ft. depth gage No. _____		
Clay		2 14		10. Screen: Manufacturer's name W.A. Brown		
Fine dry sand		14 34		Type Bridge Dia. 16		
Clay		34 86		Slot/gauze 1/8 Length _____ Set between 108 ft. and 167 ft.		
sand & gravel		86 151		Gravel pack? yes Size range of material 1/2 down		
sand & gravel good		151 166		11. Static water level: _____ mo./day/yr. 90 ft. below land surface Date _____		
shale		166 167		12. Pumping level below land surfaces: 132 ft. after 2 hrs. pumping 1000 g.p.m. _____ ft. after _____ hrs. pumping _____ g.p.m. Estimated maximum yield _____ g.p.m.		
				13. Water sample submitted: _____ mo./day/yr. Yes <input checked="" type="checkbox"/> No _____ Date _____		
				14. Well head completion: _____ Pitless adapter _____ Inches above grade		
				15. Well grouted? yes With: _____ Neat cement _____ Bentonite <input checked="" type="checkbox"/> Concrete _____ Depth: From 0 ft. to 10 ft.		
				16. Nearest source of possible contamination: NONE ft. _____ Direction _____ Type _____ Well disinfected upon completion? _____ Yes _____ No		
				17. Pump: <input checked="" type="checkbox"/> Not installed Manufacturer's name _____ Model number _____ HP _____ Volts _____ Length of drop pipe _____ ft. capacity _____ g.p.m. Type: _____ Submersible _____ Turbine _____ Jet _____ Reciprocating _____ Centrifugal _____ Other		
18. Elevation:		19. Remarks:		20. Water well contractor's certification: This well was drilled under my jurisdiction and this report is true to the best of my knowledge and belief. Johnson Drilling Business name Box 246 License No. 337 Address _____ Signed Janice Elden Date 11/18/74 Authorized representative		