

1 LOCATION OF WATER WELL	Fraction 25' West of center 1/4 1/4 NE 1/4	Section Number 2	Township Number T 27 S	Range Number R 26 E
--------------------------	---	----------------------------	----------------------------------	-------------------------------

Distance and direction from nearest town or city?

5 mi west of Dodge City, Kansas

Street address of well if located within city?

2 WATER WELL OWNER: **Patricia Condon % Ralph Monger**RR#, St. Address, Box # : **2007 East Lane**

Board of Agriculture, Division of Water Resources

City, State, ZIP Code : **Dodge City, Kansas 67801**Application Number: **27675**3 DEPTH OF COMPLETED WELL. **164** ft. Bore Hole Diameter. **28** in. to **164** ft., and in. to ft.

Well Water to be used as:

5 Public water supply

8 Air conditioning

11 Injection well

1 Domestic 3 Feedlot

6 Oil field water supply

9 Dewatering

12 Other (Specify below)

2 Irrigation 4 Industrial

7 Lawn and garden only

10 Observation well

Well's static water level **55** ft. below land surface measured on **8** month **29** day **79** yearPump Test Data : Well water was **70** ft. after **3** hours pumping. **2500** gpmEst. Yield **3500** gpm: Well water was ft. after hours pumping gpm

4 TYPE OF BLANK CASING USED:

5 Wrought iron

8 Concrete tile

Casing Joints: Glued Clamped

1 Steel

3 RMP (SR)

6 Asbestos-Cement

9 Other (specify below)

Welded **X**

2 PVC

4 ABS

7 Fiberglass

Threaded

Blank casing dia **16** in. to **64** ft., Dia in. to ft., Dia in. to ft.Casing height above land surface **12** in., weight **31.66** lbs./ft. Wall thickness or gauge No. **188**

TYPE OF SCREEN OR PERFORATION MATERIAL:

7 PVC

10 Asbestos-cement

1 Steel

3 Stainless steel

5 Fiberglass

8 RMP (SR)

11 Other (specify)

2 Brass

4 Galvanized steel

6 Concrete tile

9 ABS

12 None used (open hole)

Screen or Perforation Openings Are:

5 Gauzed wrapped

8 Saw cut

11 None (open hole)

1 Continuous slot

3 Mill slot

6 Wire wrapped

9 Drilled holes

2 Louvered shutter

4 Key punched

7 Torch cut

10 Other (specify)

Screen-Perforation Dia **16** in. to **164** ft., Dia in. to ft., Dia in. to ft.Screen-Perforated Intervals: From **64** ft. to **164** ft., From ft. to ft., From ft. to ft.

From ft. to ft., From ft. to ft., From ft. to ft.

Gravel Pack Intervals: From **10** ft. to **164** ft., From ft. to ft., From ft. to ft.

From ft. to ft., From ft. to ft., From ft. to ft.

5 GROUT MATERIAL: 1 Neat cement 2 Cement grout 3 Bentonite 4 Other

Grouted Intervals: From **0** ft. to **10** ft., From ft. to ft., From ft. to ft., From ft. to ft.

What is the nearest source of possible contamination:

1 Septic tank

4 Cess pool

7 Sewage lagoon

10 Fuel storage

14 Abandoned water well

2 Sewer lines

5 Seepage pit

8 Feed yard

11 Fertilizer storage

15 Oil well/Gas well

3 Lateral lines

6 Pit privy

9 Livestock pens

12 Insecticide storage

16 Other (specify below)

13 Watertight sewer lines **center of field ?**

Direction from well How many feet ? Water Well Disinfected? Yes No


Was a chemical/bacteriological sample submitted to Department? Yes No **X** If yes, date samplewas submitted month day year Pump Installed? Yes **X** NoIf Yes: Pump Manufacturer's name **Goulds** Model No. **12JMO** HP **80** VoltsDepth of Pump Intake **140** ft. Pumps Capacity rated at **900** gal./min.

Type of pump: 1 Submersible 2 Turbine 3 Jet 4 Centrifugal 5 Reciprocating 6 Other

3 CONTRACTOR'S OR LANDOWNER'S CERTIFICATION: This water well was (1) constructed, (2) reconstructed, or (3) plugged under my jurisdiction and was

completed on **11** month **14** day **79** yearand this record is true to the best of my knowledge and belief. Kansas Water Well Contractor's License No. **190**This Water Well Record was completed on **12** month **14** day **79** year under the businessname of **Ace-Hi International** by (signature) **Carl G. Tittel**

7 LOCATE WELL'S LOCATION WITH AN "X" IN SECTION BOX:

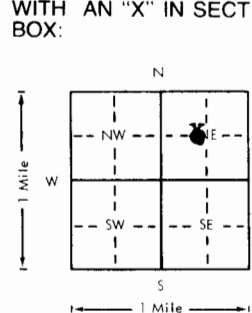

FROM TO LITHOLOGIC LOG FROM TO LITHOLOGIC LOG

0

3

Surface

3

24

Fine sand and sandy clay

24

67

Med. sand and gravel

67

98

Fine to med. sand and gravel with 15% clay

98

122

Med. sand and gravel with cemented streaks

122

143

Fine to med. sand with large rocks

143

146

Sandy clay

146

155

Gravel and large rock

155

161

Sand and gravel

161

164

Yellow clay and blue shale

ELEVATION: **161** **164**Depth(s) Groundwater Encountered 1. **55** ft. 2. ft. 3. ft. 4. ft. (Use a second sheet if needed)

INSTRUCTIONS: Use typewriter or ball point pen, please press firmly and PRINT clearly. Please fill in blanks, underline or circle the correct answers. Send top three copies to Kansas Department of Health and Environment, Division of Environment, Water Well Contractors, Topeka, KS 66620. Send one to WATER WELL OWNER and retain one for your records.

OFFICE USE ONLY

T

27

R

24

EW

SEC.

2

1/4 CNE 1/4

1/4