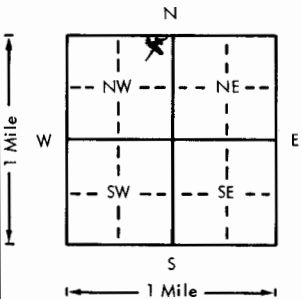


USE TYPEWRITER OR BALL
POINT PEN-PRESS FIRMLY,
PRINT CLEARLY.

WATER WELL RECORD
KSA 82a-1201-1215

Kansas Department of Health and
Environment-Division of Environment
(Water well Contractors)
Topeka, Kansas 66620

Location of well: X		County: Ford County	Fraction: NE 1/4 NE 1/4 NW 1/4	Section number: 10	Township number: T 27 S.	Range number: R 26 E/W		
2. Distance and direction from nearest town or city: from Howell 3 miles South, 2 East, 1 South 1/2 West, on south of Owner of well: Vern Goetz Street address of well location if in city: road go from windmill 700' West R.R. or street: Rt. #2 City, state, zip code: Dodge City, KS 67801								
4. Locate with "X" in section below:			Sketch map:		6. Bore hole dia. 26 in. Completion date 3-31-78 Well depth 160 ft.			
					7. Cable tool <input type="checkbox"/> Rotary <input type="checkbox"/> Driven <input type="checkbox"/> Dug <input type="checkbox"/> Hollow rod <input type="checkbox"/> Jetted <input type="checkbox"/> Bored <input checked="" type="checkbox"/> Reverse rotary			
5. Type and color of material			From		To		8. Use: <input type="checkbox"/> Domestic <input type="checkbox"/> Public supply <input type="checkbox"/> Industry <input checked="" type="checkbox"/> Irrigation <input type="checkbox"/> Air conditioning <input type="checkbox"/> Stock <input type="checkbox"/> Lawn <input type="checkbox"/> Oil field water <input type="checkbox"/> Other	
							9. Casing: Material Steel Height: Above or below Threaded <input type="checkbox"/> Welded <input checked="" type="checkbox"/> Surface 1 ft. in. RMP <input type="checkbox"/> PVC <input type="checkbox"/> Weight 36.87 lbs./ft. Dia. 16 in. to 160 ft. depth Wall Thickness: inches or Dia. <input type="checkbox"/> in. to <input type="checkbox"/> ft. depth gage No. .219	
							10. Screen: Manufacturer's name Johnson Type Johnson Galv. Dia. 100 - 16" Slot/gauze 0-120 Plain in. Set between 120-150 Screen ft. 150-160 Perf. ft. Gravel pack? yes Size range of material 1/2 to 5/8	
							11. Static water level: <input type="checkbox"/> mo./day/yr. 96 ft. below land surface Date 3-22-78	
							12. Pumping level below land surfaces: 112 ft. after 2 hrs. pumping 825 g.p.m. 121 ft. after 4 hrs. pumping 1275 g.p.m. Estimated maximum yield 1275 g.p.m.	
(Use a second sheet if needed)							13. Water sample submitted: <input type="checkbox"/> Yes <input checked="" type="checkbox"/> No Date	
							14. Well head completion: <input type="checkbox"/> Pitless adapter 1 ft. inches above grade	
							15. Well grouted? yes With: <input type="checkbox"/> Neat cement <input type="checkbox"/> Bentonite <input checked="" type="checkbox"/> Concrete Depth: From 0 ft. to 10 ft.	
							16. Nearest source of possible contamination: ft. <input type="checkbox"/> Direction N/A Type <input checked="" type="checkbox"/> No Well disinfected upon completion? <input type="checkbox"/> Yes <input checked="" type="checkbox"/> No	
							17. Pump: <input type="checkbox"/> Not installed Manufacturer's name Could 5 sts. 12" JHC Model number 911709 HP 125 Volts Length of drop pipe 150 ft. capacity 800 g.p.m. Type: <input type="checkbox"/> Submersible <input checked="" type="checkbox"/> Turbine <input type="checkbox"/> Jet <input type="checkbox"/> Reciprocating <input type="checkbox"/> Centrifugal <input type="checkbox"/> Other	
18. Elevation:		19. Remarks:		20. Water well contractor's certification: This well was drilled under my jurisdiction and this report is true to the best of my knowledge and belief. Minter-Wilson Drilling 208 Business name License No. Address Box A, Garden City, KS Signed <i>[Signature]</i> Date <i>[Date]</i> Authorized representative				

Forward the white, blue and pink copies to the Department of Health and Environment

Form WWC-5

The Professionals **MINTER-WILSON DRILLING CO.** Complete Installation and Repairing
INCORPORATED

Phone 276-8269 • P.O. Box A • GARDEN CITY, KANSAS 67846

Vernon Goetz
Ford Country
3-8-78

Location: NW 10-27-26 from Howell 3 miles south,
2 miles east, 1 mile south, $\frac{1}{2}$ mile west
on south of road go from
windmill 700 ft. west

Test #1

Static Water Level - 95'

0	22	Top soil
22	27	Fine sand Loose
27	33	Fine to med. sand and gravel Loose
33	69	Brown clay
69	82	Fine to med. sand
82	123	Fine to med. sand and gravel Loose
123	134	Med. coarse gravel Loose
134	143	Coarse gravel
143	152	Med. sand to med. coarse gravel Loose
152	156	Yellow clay
156	163	Shale

TD 160

~~30 Screen~~

120 Plain

30 Screen

10 Perf.