USE TYPEWRITER OR BALL POINT PEN-PRESS FIRMLY, PRINT CLEARLY.

T R EW sec 1/4 1/4 1/4 No.

WATER WELL RECORD
KSA 82a-1201-1215

Kansas State Dept. Of Health
(Water Well Contractors)
Forbes-Bldg. 740
Topeka, Kansas 66620

1 Location of well:	County	Township name	Section	Section number	Town number	Range number
	FORD	FAIRVIEW S	N/E 1/4 S/E 1/4 1/4	11	27	26

Distance and direction from nearest town or city: 5 S/W of 56 DODGE City, KANSAS

Street address of well location if in city:

3 Owner of well: Richard Johnson

Address: Ensign, Ks. 67841

Locate with "X" in section below:

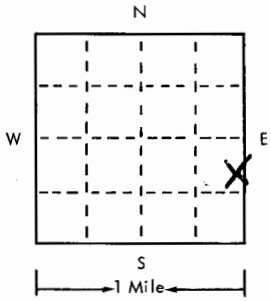

Sketch map:

2 Type and color of material	From	To
surface	0	3
clay	3	18
dry silty sand & clay	18	84
clay & caliche	84	103
sand & gravel	103	143
clay	143	150
(use a second sheet if needed)		

4 Well depth: 150 ft. Date of completion ____
Well diameter 28 in.

5 ☐ Cable tool ☐ Rotary ☐ Driven ☐ Dug ☐ Hollow rod ☐ Jetted ☐ Bored ☒ Reverse rotary

6 Use: ☐ Domestic ☐ Public supply ☐ Industry ☒ Irrigation ☐ Air conditioning ☐ Commercial ☐ Test well ☐ ____

7 Casing: Material st. Height: above/below
Threaded ☐ Welded ☒ Surface ____ in.
Diam. Weight ____ lbs./ft.
16 in. to 110 ft. depth Drive shoe? ☐ Yes ☐ No
____ in. to ____ ft. depth

8 Screen:
Manufacturer W. A. Brown
Type Bridge Dia. 16
Slot/gauze 75 Length ____
Set between 110 ft. and 150 ft.
Fittings:
Gravel pack ☒ Yes ☐ No Size range of material 1/2 down

9 Static water level:
102 ft. below land surface Date ____

10 Pumping level below land surfaces:
126 ft. after 4 hrs. pumping 950 g.p.m.
____ ft. after ____ hrs. pumping ____ g.p.m.
Estimated maximum yield ____ g.p.m.

11 Water sample submitted:
☐ Yes ☒ No Date ____

12 Well head completion:
☐ Pitless adapter ☐ Inches above grade

13 Well grouted? ☒ Yes ☐ No
☐ Neat cement ☐ Bentonite ☐ Concrete
Depth: From 0 ft. to 10 ft.

14 Nearest source of possible contamination:
ft. ____ Direction ____ Type NONE
Well disinfected upon completion? ☐ Yes ☐ No

15 Pump: ☐ Not installed
Manufacturer's name Western Land Roller
Model number ____ HP ____ Volts ____
Length of drop pipe 140 ft. capacity 950 g.m.p.
Type:
☐ Submersible ☒ Turbine
☐ Jet ☐ Reciprocating
☐ Certrifugal ☐ Other

16 Remarks: elevation

Topography:
☒ Hill
☐ Slope
☐ Upland
☐ Valley

17 Water well contractor's certification:
This well was drilled under my jurisdiction and this report is true to the best of my knowledge and belief.
Johnson Drilling 337
Business name License No.
Address Box 546
Signed Janice Alder Date 11/18/26
Authorized representative

27 26 W 11 SENESE

Forward the white, blue and pink copies to the Kansas State Dept. Of Health.

Form WWC-5