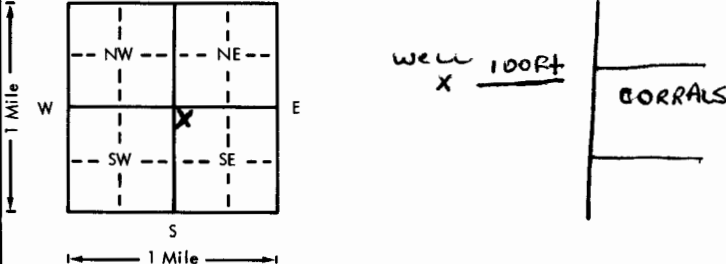


USE TYPEWRITER OR BALL  
POINT PEN-PRESS FIRMLY,  
PRINT CLEARLY.

WATER WELL RECORD  
KSA 82a-1201-1215

Kansas Department of Health and  
Environment-Division of Environment  
(Water well Contractors)  
Topeka, Kansas 66620

1. Location of well:		County <b>FORD</b>	Fraction <b>NW 1/4 NW 1/4 SE 1/4</b>	Section number <b>26</b>	Township number <b>T 27 S</b>	Range number <b>R 26 E/W</b>
2. Distance and direction from nearest town or city: <b>7 miles SE of Dodge City</b>				3. Owner of well: <b>Sentinel Cattle Co.</b> R.R. or street: <b>Dodge City KS</b> City, state, zip code:		
4. Locate with "X" in section below: N W E S 1 Mile Sketch map: 				6. Bore hole dia. <b>9</b> in. Completion date <b>13/4/76</b> Well depth <b>210</b> ft.		
5. Type and color of material				7. <input checked="" type="checkbox"/> Cable tool <input checked="" type="checkbox"/> Rotary <input type="checkbox"/> Driven <input type="checkbox"/> Dug <input type="checkbox"/> Hollow rod <input type="checkbox"/> Jetted <input type="checkbox"/> Bored <input type="checkbox"/> Reverse rotary		
				8. Use: <input type="checkbox"/> Domestic <input type="checkbox"/> Public supply <input type="checkbox"/> Industry <input type="checkbox"/> Irrigation <input type="checkbox"/> Air conditioning <input checked="" type="checkbox"/> Stock <input type="checkbox"/> Lawn <input type="checkbox"/> Oil field water <input type="checkbox"/> Other		
				9. Casing: Material <b>PVC</b> Height: <b>Above</b> or below Threaded <input type="checkbox"/> Welded <input type="checkbox"/> Surface <b>20</b> in. RMP <input type="checkbox"/> PVC <input checked="" type="checkbox"/> Weight <b>250</b> lbs./ft. Dia. <b>5</b> in. to <b>210</b> ft. depth Wall Thickness: inches or Dia. <input type="checkbox"/> in. to <input type="checkbox"/> ft. depth gage No. <b>250</b>		
				10. Screen: Manufacturer's name <b>Jesse &amp; Lowell</b> Type <b>PVC</b> Dia. <b>5</b> Slot/gauze <b>1/16</b> Length <b>3</b> Set between <b>180</b> ft. and <b>210</b> ft. ft. and ft. Gravel pack? <input checked="" type="checkbox"/> Size range of material <b>1/8</b>		
				11. Static water level: <b>167</b> ft. below land surface Date <b>4/23/76</b> mo./day/yr.		
				12. Pumping level below land surfaces: <b>N/A</b> ft. after hrs. pumping g.p.m. ft. after hrs. pumping g.p.m. Estimated maximum yield g.p.m.		
				13. Water sample submitted: mo./day/yr. Yes <input checked="" type="checkbox"/> No <input type="checkbox"/> Date		
				14. Well head completion: <input checked="" type="checkbox"/> Pitless adapter <b>20</b> inches above grade		
				15. Well grouted? <input checked="" type="checkbox"/> With: <input checked="" type="checkbox"/> Neat cement <input type="checkbox"/> Bentonite <input type="checkbox"/> Concrete Depth: From <b>3</b> ft. to <b>13</b> ft.		
				16. Nearest source of possible contamination: ft. <b>100</b> Direction <b>E</b> Type <b>CORRAL</b> Well disinfected upon completion? <input checked="" type="checkbox"/> Yes <input type="checkbox"/> No		
				17. Pump: Manufacturer's name <b>Reda</b> Not installed Model number <b>170 DMP</b> HP <b>1 1/2</b> Volts <b>200</b> Length of drop pipe <b>189</b> ft. capacity <b>1000 g.p.m.</b> Type: <input checked="" type="checkbox"/> Submersible <input type="checkbox"/> Turbine <input type="checkbox"/> Jet <input type="checkbox"/> Reciprocating <input type="checkbox"/> Centrifugal <input type="checkbox"/> Other		
(Use a second sheet if needed)						
18. Elevation:		19. Remarks:		20. Water well contractor's certification: This well was drilled under my jurisdiction and this report is true to the best of my knowledge and belief. <b>CRAGG PRILLING</b> <b>111</b> Business name License No. Address <b>RT 1 DCK</b> Signed <b>Clay D. Prilling</b> Date <b>4/13/76</b> Authorized representative		
Topography: <input type="checkbox"/> Hill <input checked="" type="checkbox"/> Slope <input type="checkbox"/> Upland <input type="checkbox"/> Valley						