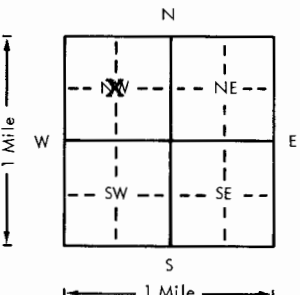


USE TYPEWRITER OR BALL
POINT PEN-PRESS FIRMLY,
PRINT CLEARLY.

WATER WELL RECORD
KSA 82a-1201-1215

Kansas Department of Health and
Environment-Division of Environment
(Water well Contractors)
Topeka, Kansas 66620

1. Location of well:		County Ford	Fraction Center 1/4 1/4 NW 1/4	Section number 33	Township number T 27 S R	Range number 26 E/W
2. Distance and direction from nearest town or city: 3E & 1N of Ensign, Ks. Street address of well location if in city:			3. Owner of well: BEL Farms R.R. or street: 508 Annette City, state, zip code: Dodge City, Kansas 67801			
4. Locate with "X" in section below:		Sketch map:		6. Bore hole dia. <u>28</u> in. Completion date _____ Well depth _____ ft. <u>4-9-77</u>		
				7. Cable tool _____ Rotary _____ Driven _____ Dug _____ Hollow rod _____ Jetted _____ Bored <input checked="" type="checkbox"/> Reverse rotary		
5. Type and color of material		From	To	8. Use: Domestic _____ Public supply _____ Industry _____ <input checked="" type="checkbox"/> Irrigation _____ Air conditioning _____ Stock _____ Lawn _____ Oil field water _____ Other _____		
Surface		0	3	9. Casing: Material <u>steel</u> Height: Above or below _____ Threaded _____ Welded <input checked="" type="checkbox"/> Surface <u>12</u> in. RMP _____ PVC _____ Weight _____ lbs./ft.		
Brown clay		3	65	Dia. <u>16</u> in. to <u>0</u> ft. depth Wall Thickness: inches or _____ Dia. <u>16</u> in. to <u>160</u> ft. depth gage No. <u>188</u>		
Fine Sand & 30% clay mixed		65	77	10. Screen: Manufacturer's name _____ <u>W. A. Brown</u>		
Fine Sand & 5% Clay mixed		77	131	Type <u>Bridge</u> Dia. <u>16</u> Slot/gauze <u>17% .188</u> Length <u>40'</u> Set between <u>160</u> ft. and <u>300</u> ft. _____ ft. and _____ ft.		
Brown clay		131	152	Gravel pack? <input checked="" type="checkbox"/> Size range of material <u>1/2 x 5/8</u>		
Good med. sand & gravel, few hard rock stringers from 270' on		152	292	11. Static water level: _____ mo./day/yr. <u>154</u> ft. below land surface Date <u>5-20-77</u>		
Yellow clay		292	294	12. Pumping level below land surfaces: _____ ft. after _____ hrs. pumping _____ g.p.m. _____ ft. after _____ hrs. pumping _____ g.p.m. Estimated maximum yield <u>No Test Pump</u> g.p.m.		
Blue shale		294	300	13. Water sample submitted: _____ mo./day/yr. Yes <input checked="" type="checkbox"/> No _____ Date _____		
				14. Well head completion: _____ Pitless adapter <u>12</u> Inches above grade		
				15. Well grouted? <u>yes</u> With: _____ Neat cement <input checked="" type="checkbox"/> Bentonite _____ Concrete _____ Depth: From <u>0</u> ft. to <u>10</u> ft.		
				16. Nearest source of possible contamination: ft. <u>3/8-2</u> Direction <u>E of</u> Type <u>Farm</u> Well disinfected upon completion? Yes <input checked="" type="checkbox"/> No _____		
				17. Pump: _____ Not installed Manufacturer's name <u>Western Land Roller</u> Model number <u>12KBH</u> HP <u>125</u> Volts _____ Length of drop pipe <u>280</u> ft. capacity <u>1000</u> g.p.m. Type: _____ Submersible <input checked="" type="checkbox"/> Turbine _____ _____ Jet _____ Reciprocating _____ _____ Centrifugal _____ Other _____		
18. Elevation:		19. Remarks:		20. Water well contractor's certification: This well was drilled under my jurisdiction and this report is true to the best of my knowledge and belief. <u>Woofter Drilling Inc. 343</u> Business name _____ License No. _____ Address <u>Hwy 56, Dodge City, KS</u> Signed <u>M. Schuchman</u> Date <u>12/11/74</u> Authorized representative		

27 260 33 200
1/4 1/4 1/4 1/4