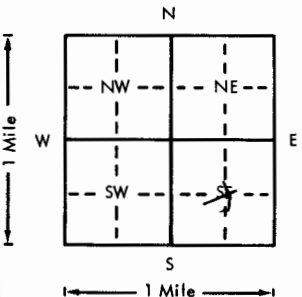


USE TYPEWRITER OR BALL
POINT PEN-PRESS FIRMLY,
PRINT CLEARLY.

WATER WELL RECORD
KSA 82a-1201-1215

Kansas Department of Health and
Environment-Division of Environment
(Water well Contractors)
Topeka, Kansas 66620

1. Location of well:		County <u>Ford</u>	Fraction <u>C 1/4 SE 1/4 1/4</u>	Section number <u>#36</u>	Township number <u>T 21</u>	Range number <u>S R 26 E/W</u>
2. Distance and direction from nearest town or city: <u>4W 4S 4W 4N Dodge City</u> Street address of well location if in city:			3. Owner of well: <u>Grady Robinson</u> R.R. or street: <u>RR 1</u> City, state, zip code: <u>Dodge City, Mo 67801</u>			
4. Locate with "X" in section below:		Sketch map:		6. Bore hole dia. <u>8</u> in. Completion date _____ Well depth <u>190</u> ft.		
				7. <input type="checkbox"/> Cable tool <input type="checkbox"/> Rotary <input type="checkbox"/> Driven <input type="checkbox"/> Dug <input type="checkbox"/> Hollow rod <input type="checkbox"/> Jetted <input type="checkbox"/> Bored <input checked="" type="checkbox"/> Reverse rotary		
5. Type and color of material		From	To	8. Use: <input type="checkbox"/> Domestic <input type="checkbox"/> Public supply <input type="checkbox"/> Industry <input checked="" type="checkbox"/> Irrigation <input type="checkbox"/> Air conditioning <input type="checkbox"/> Stock <input type="checkbox"/> Lawn <input type="checkbox"/> Oil field water <input type="checkbox"/> Other		
<u>Surface</u>		<u>0</u>	<u>2</u>	9. Casing: Material <u>STEEL</u> Height: <u>Above</u> or below Threaded <input type="checkbox"/> Welded <input checked="" type="checkbox"/> Surface <u>8</u> in. RMP <input type="checkbox"/> PVC <input type="checkbox"/> Weight _____ lbs./ft. Dia. <u>1 1/2</u> in. to <u>1 1/2</u> ft. depth Wall Thickness: inches or Dia. _____ in. to _____ ft. depth gage No. <u>188</u>		
<u>Clay</u>		<u>2</u>	<u>61</u>	10. Screen: Manufacturer's name <u>D.A. Brown</u> Type <u>Bridge</u> Dia. <u>10</u> Slot/gauze <u>28</u> Length _____ Set between <u>130</u> ft. and <u>190</u> ft. _____ ft. and _____ ft. Gravel pack? <u>yes</u> Size range of material <u>1/2 down</u>		
<u>Sand & clay</u>		<u>61</u>	<u>86</u>	11. Static water level: _____ mo./day/yr. <u>134</u> ft. below land surface Date _____		
<u>Fine sand & clay layers</u>		<u>86</u>	<u>123</u>	12. Pumping level below land surfaces: <u>147</u> ft. after <u>3</u> hrs. pumping <u>1100</u> g.p.m. _____ ft. after _____ hrs. pumping _____ g.p.m. Estimated maximum yield <u>1100</u> g.p.m.		
<u>Sand & gravel</u>		<u>123</u>	<u>185</u>	13. Water sample submitted: _____ mo./day/yr. Yes <input checked="" type="checkbox"/> No <input type="checkbox"/> Date _____		
<u>Clay</u>		<u>185</u>	<u>189</u>	14. Well head completion: _____ _____ Pitless adapter _____ Inches above grade		
<u>Shale</u>		<u>189</u>	<u>190</u>	15. Well grouted? <u>yes</u> With: <input type="checkbox"/> Neat cement <input type="checkbox"/> Bentonite <input checked="" type="checkbox"/> Concrete Depth: From <u>5</u> ft. to <u>10</u> ft.		
				16. Nearest source of possible contamination: <u>NONE</u> ft. _____ Direction _____ Type _____ Well disinfected upon completion? _____ Yes _____ No		
				17. Pump: _____ Not installed Manufacturer's name <u>Hydro</u> Model number _____ HP _____ Volts _____ Length of drop pipe <u>160</u> ft. capacity <u>1100</u> g.p.m. Type: _____ <input type="checkbox"/> Submersible <input checked="" type="checkbox"/> Turbine <input type="checkbox"/> Jet <input type="checkbox"/> Reciprocating <input type="checkbox"/> Centrifugal <input type="checkbox"/> Other		
18. Elevation:		19. Remarks:		20. Water well contractor's certification: This well was drilled under my jurisdiction and this report is true to the best of my knowledge and belief. <u>J. O. Johnson Drilling</u> <u>183</u> Business name _____ License No. _____ Address _____ Signed <u>Janice Alder</u> Date <u>6/76</u> Authorized representative		